


U2291/30 - Higher Backway, Bruton

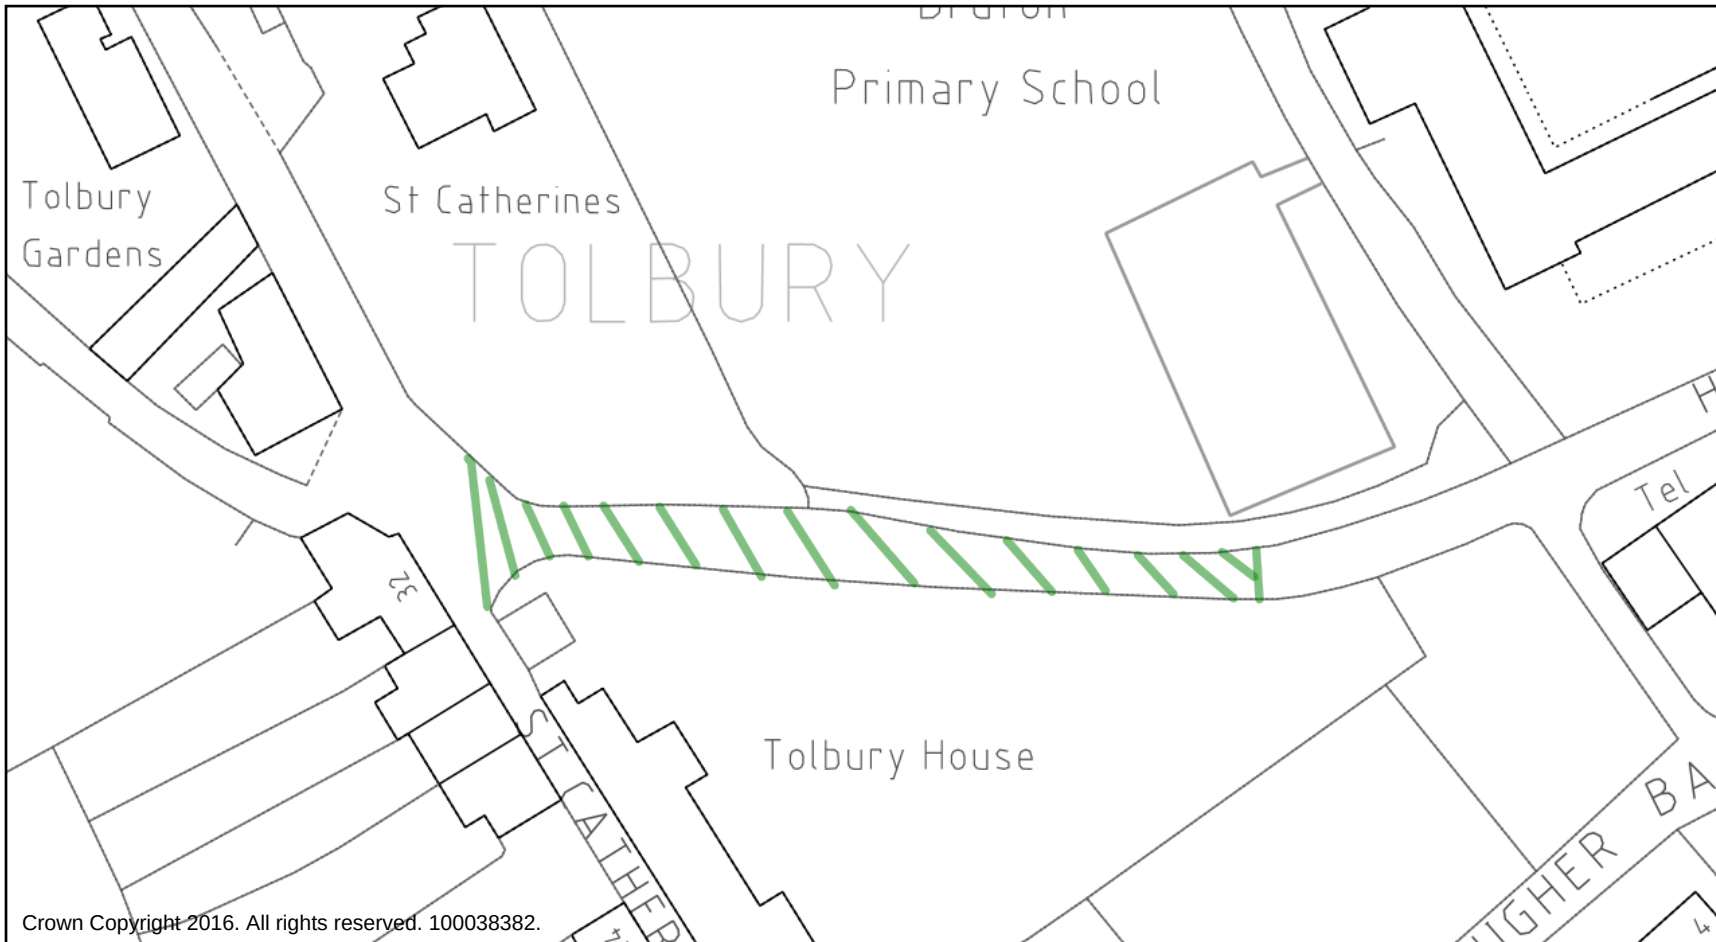

Green Lines = No Waiting At Any Time

PCs

Thrippound Cott

Patwell Ho

Patwell Cott

Patwell Cott

Pottery Cottage

Moray House

Brue Villa FB

Surgery

PO

The Wisp

Buck Ho

Hadrian Ho

Library

Granary

1

2

4

6

8

10

14

1

7

13

13a

The Old Bull Inn

Patwell Street

Patwell Lane

Grove Alley

River Brue


Bridge

Weir

Crown Copyright 2016. All rights reserved. 100038382.


Black Circle = Triangle area
between Patwell Street,
Grove Alley and Patwell
Lane proposed 1 hour
limited waiting
8am - 6pm Mon - Sat

U9458/10 - Boundary Road

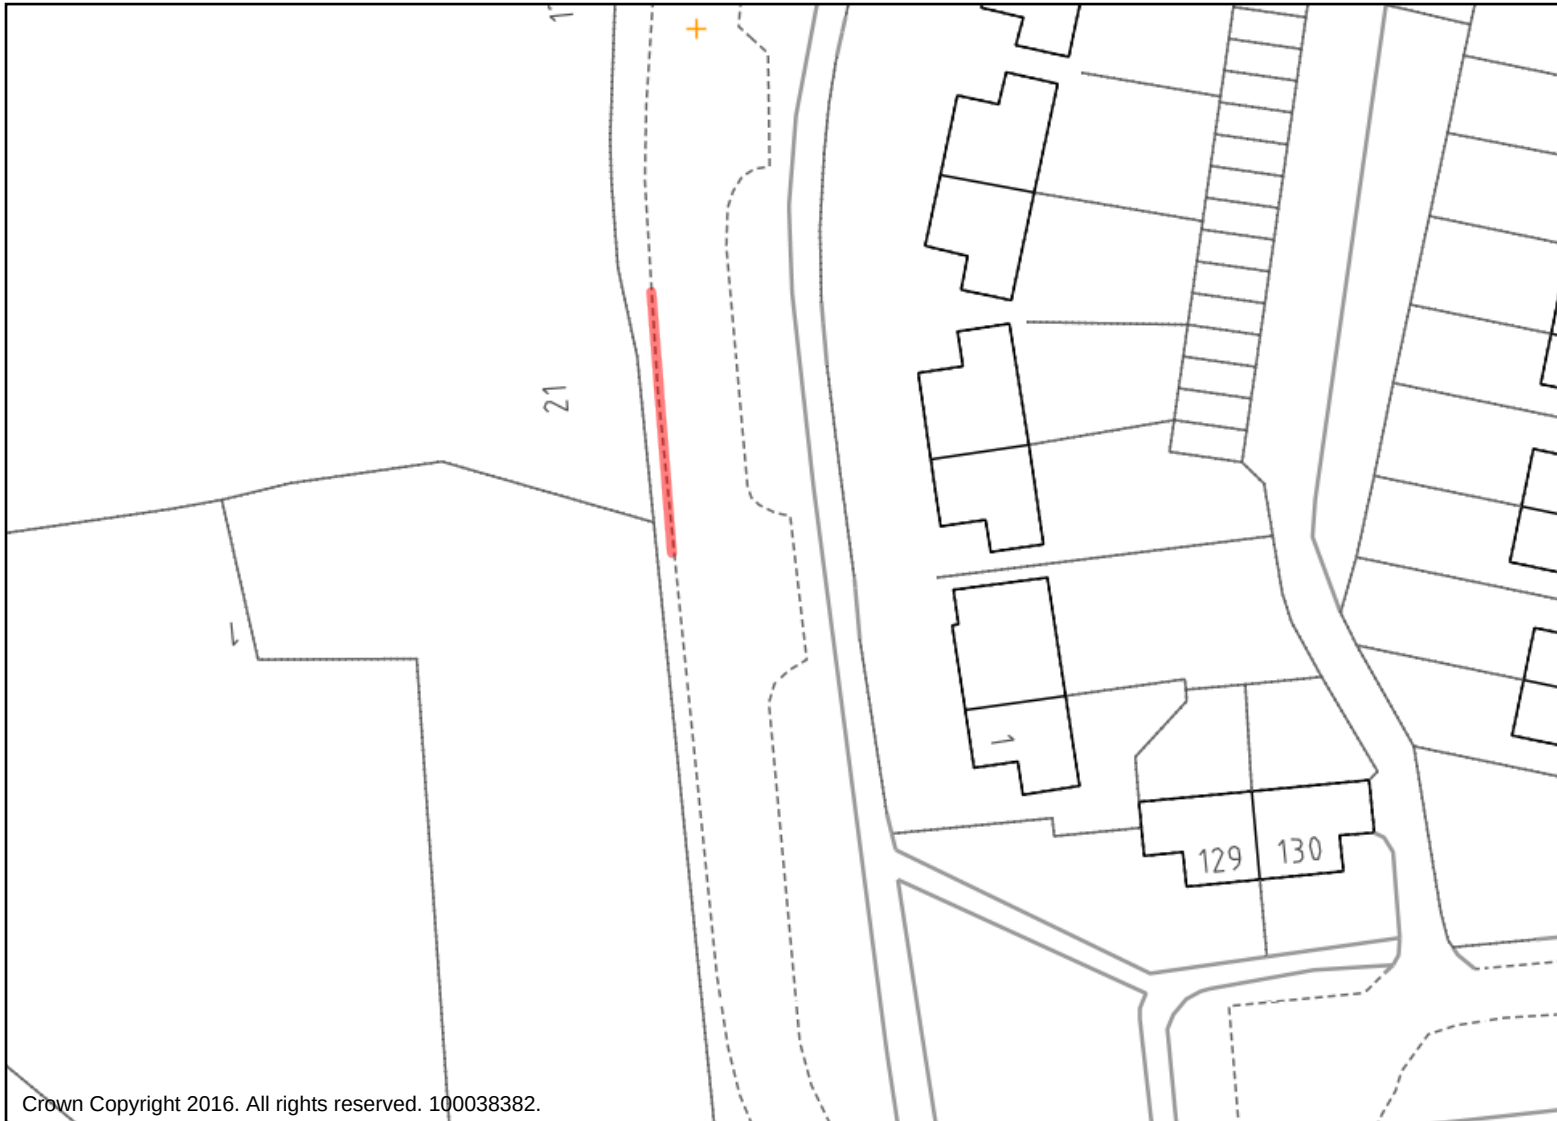

Red Line = Double Yellow Lines to
go in 10m either side of the entrance
of Osprey Close

U5525/20 - Alvington Lane, Brympton, Yeovil

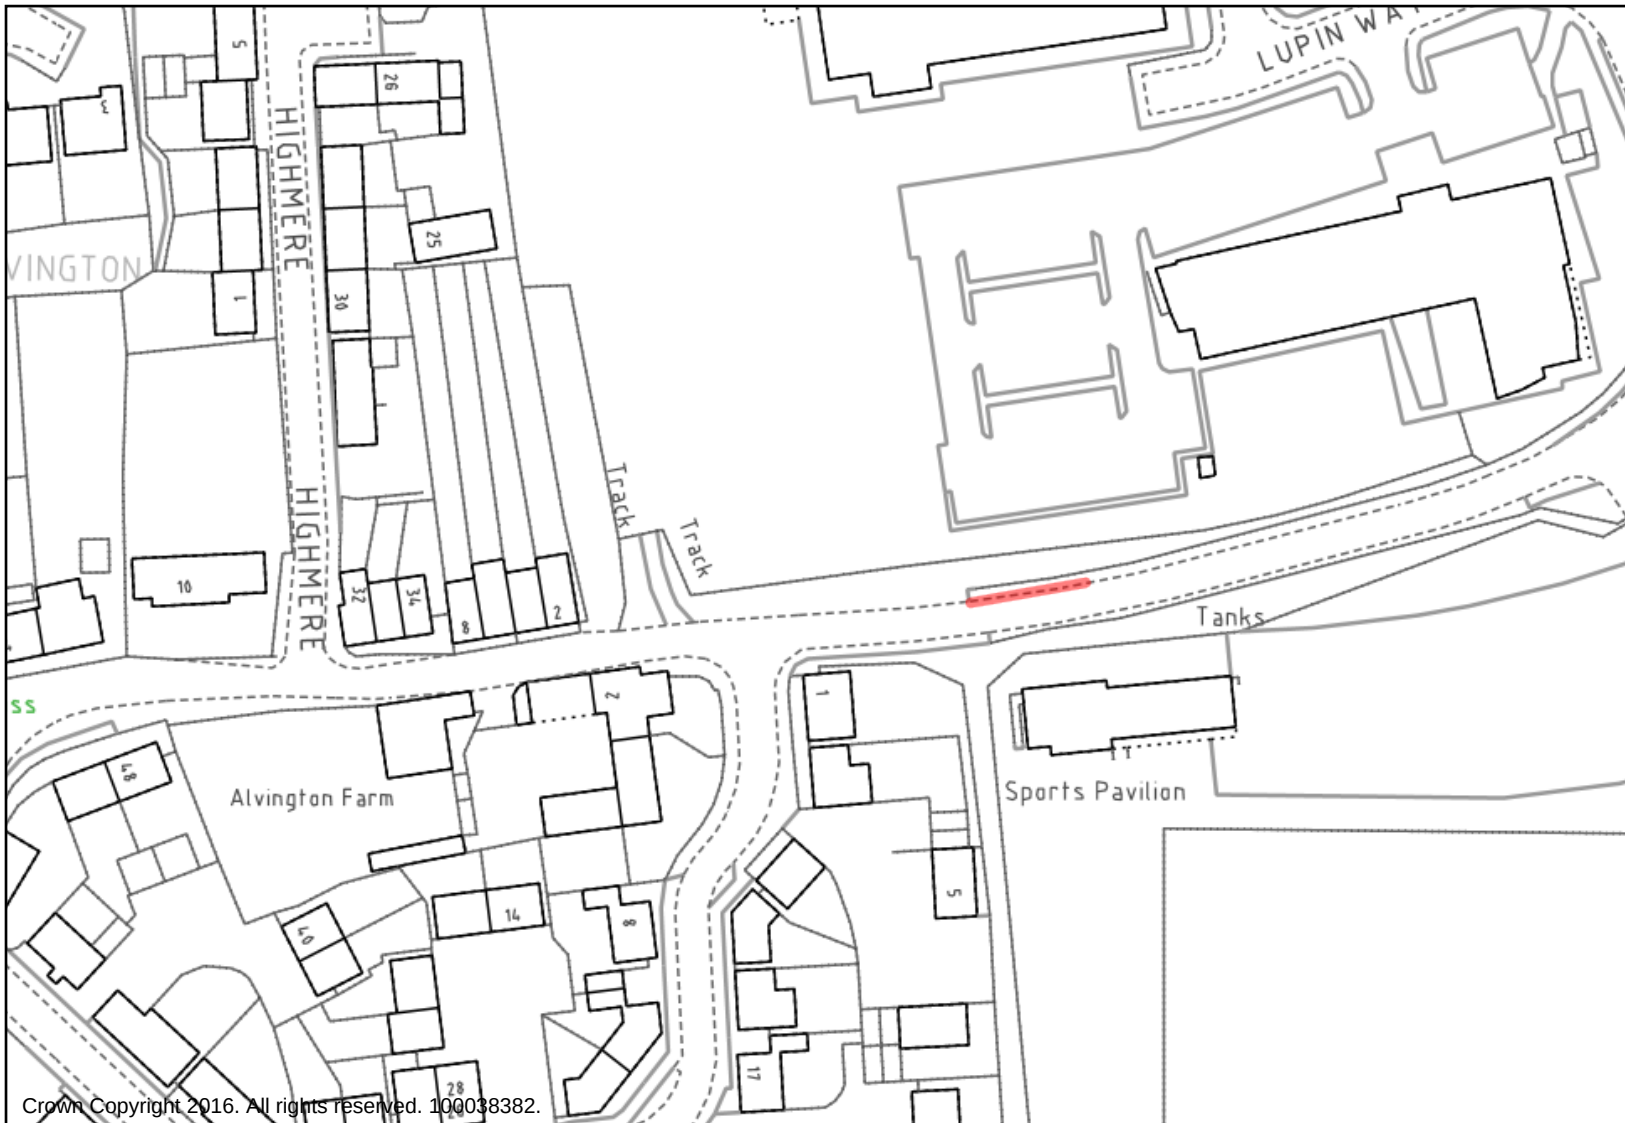

Red Line = New double yellow lines

U8183/10 Monks Dale, Brympton, Yeovil




Red line = extension of existing
double yellow lines

U8477/110 Westminster, Brympton, Yeovil



Red Line = extension to existing
double yellow lines

U8776/10 Beeching Close, Chard

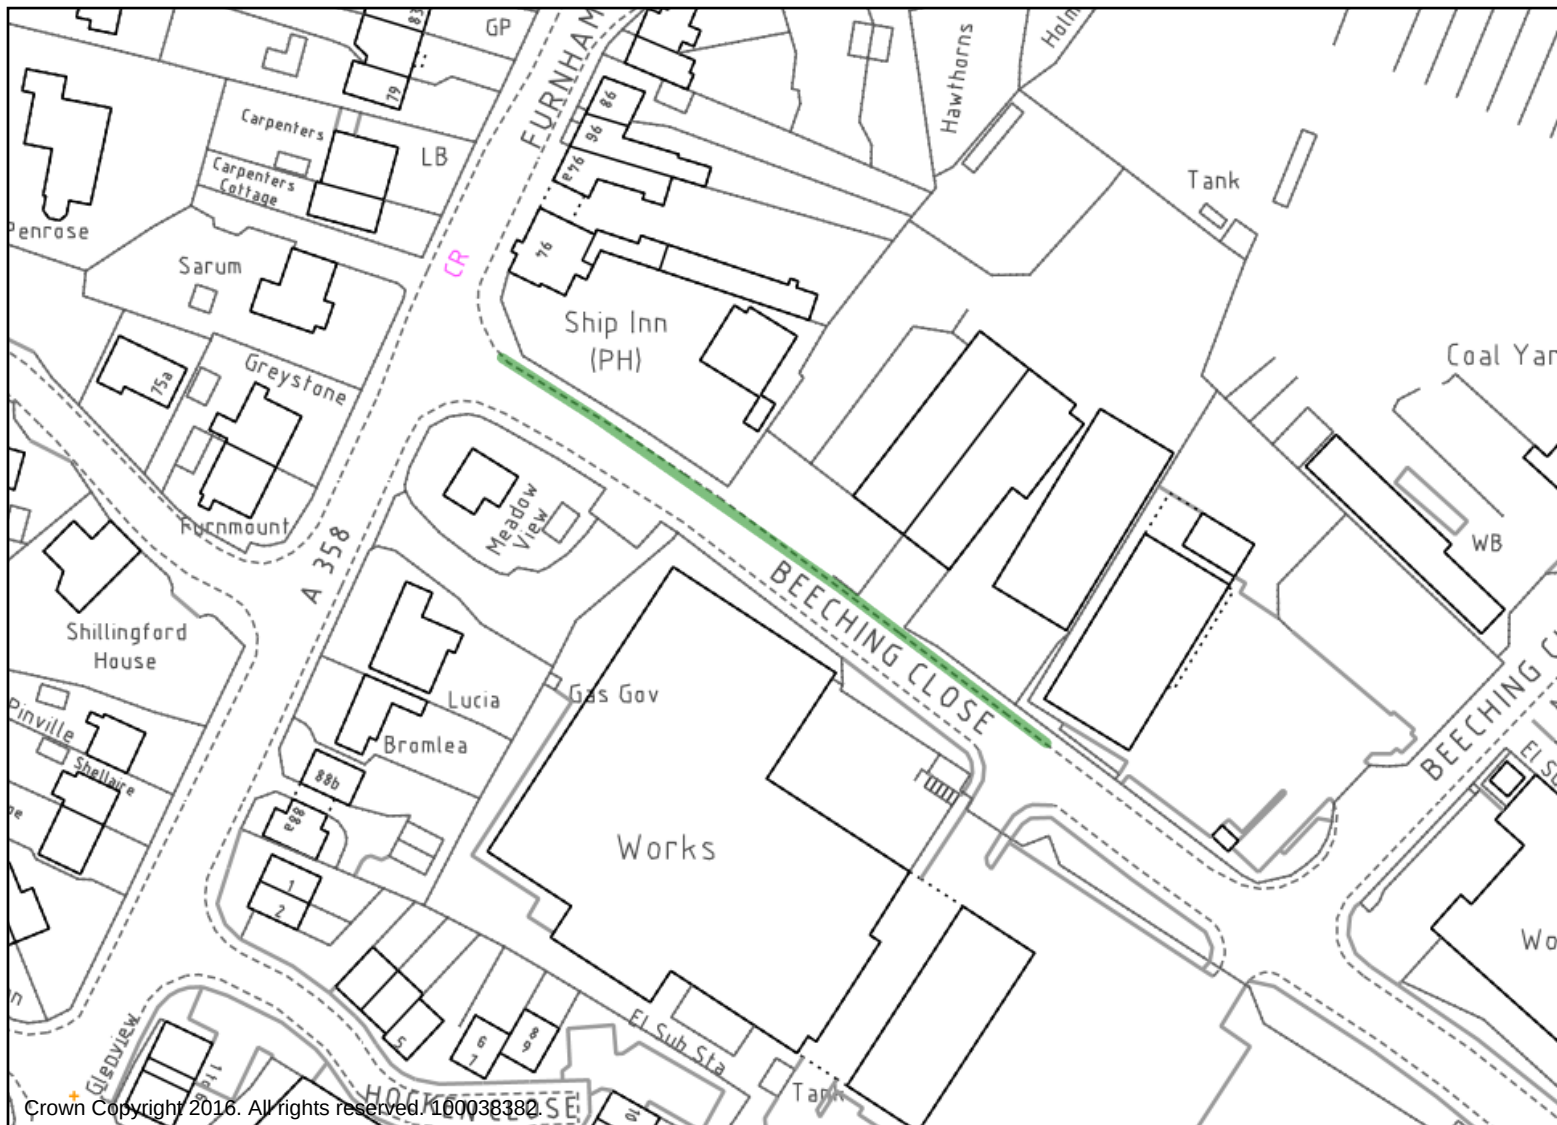

Green Line = No Waiting
Mon - Sat 8am - 6pm

U8784/60 Elizabeth Way Chard

(including junctions - U8784/70 Redstart Road, U8784/340 Robins Court, U9375/10 Mervyn Ball Close, U8784/120 Bampton Avenue, U8784/150 Lillington Way)

Green Lines = No Waiting At Any Time




U8812/10 Avishayes Road, Chard




Green Line = amend timings of
No Waiting to
Mon - Fri 9am - 4pm

U8760/20 Boden Street, Chard

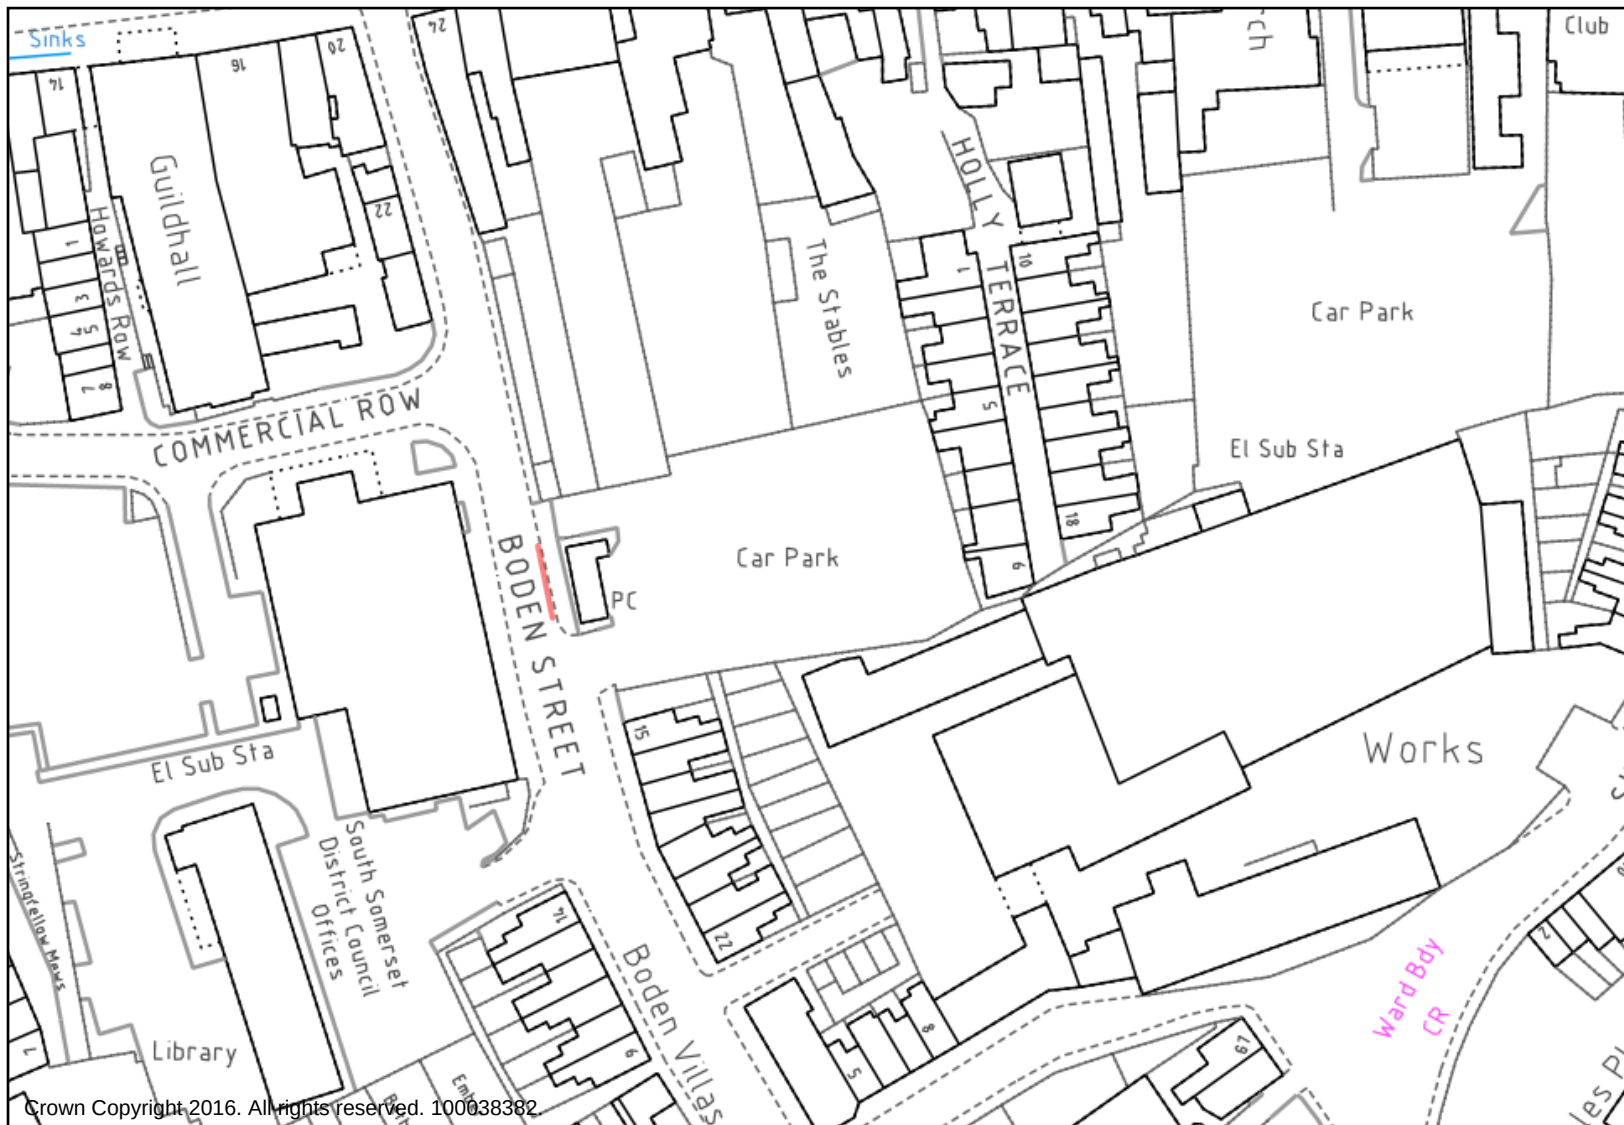


Red Line = Remove double yellow lines and hatching and replace with 2 no: disabled parking bays

A30/70 High Street/ T8974 Holyrood Street, Chard

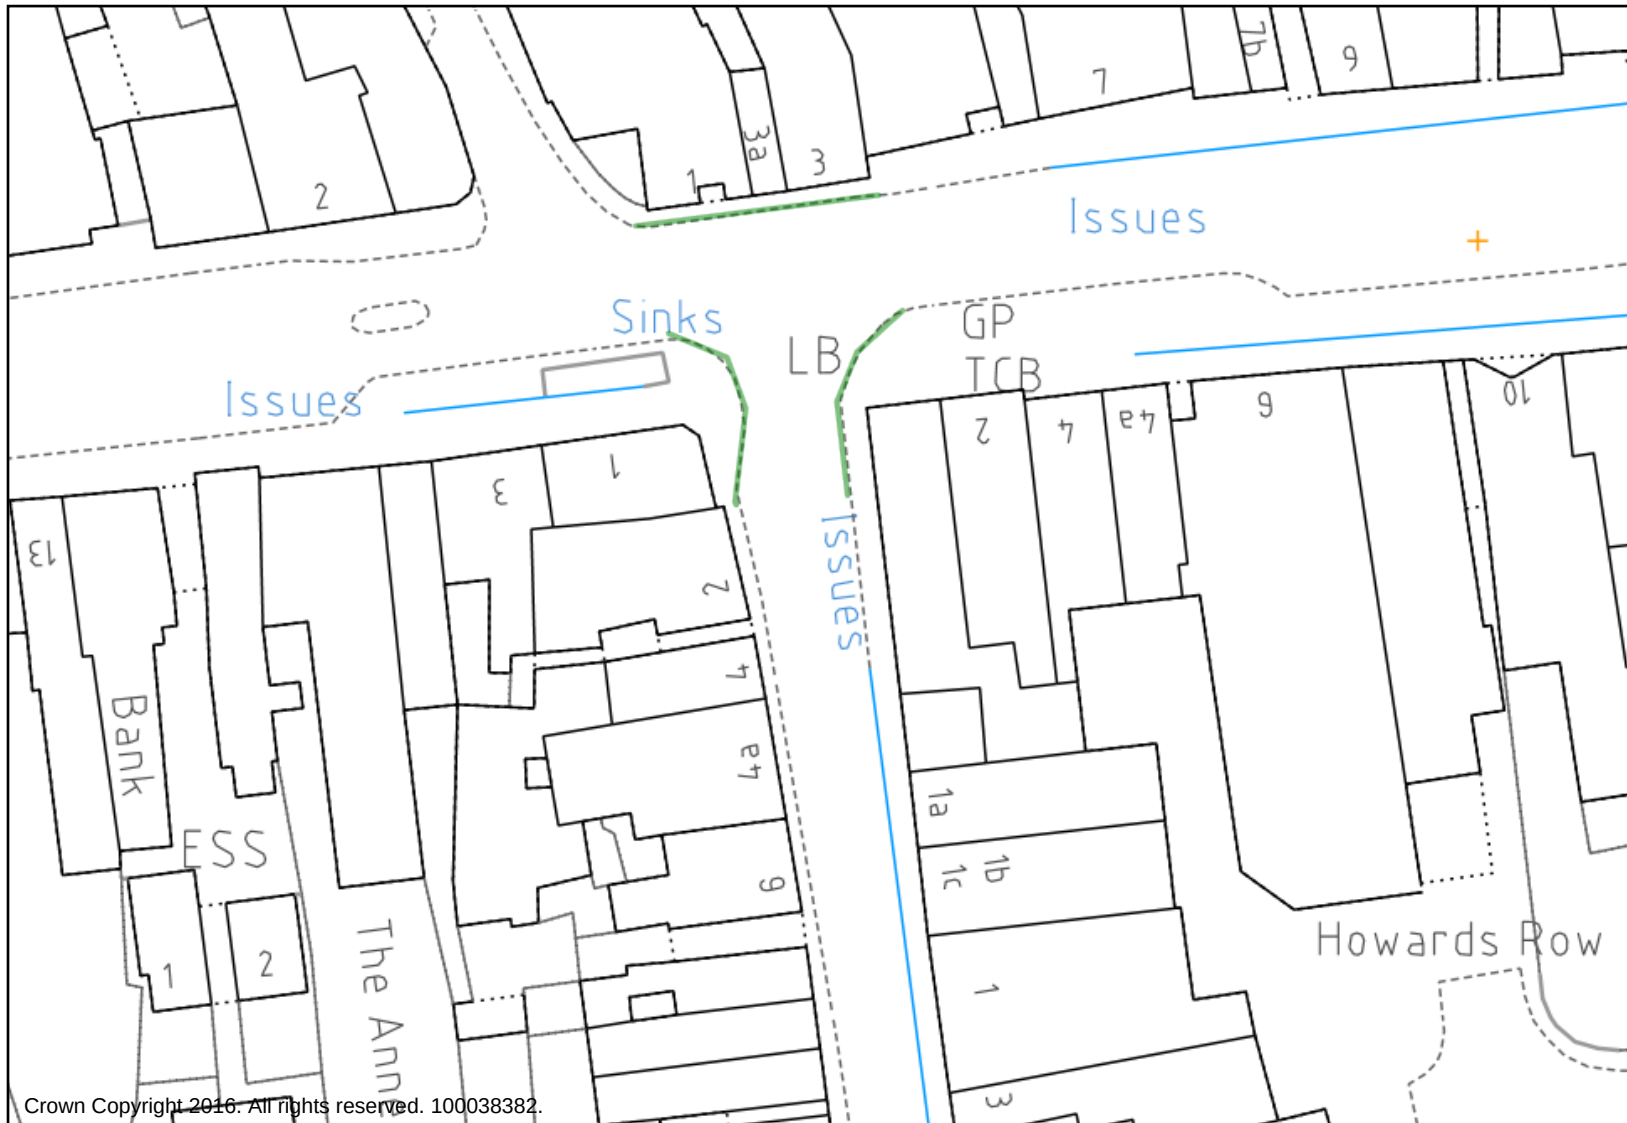

Green Line = introduce
no loading blips to prevent
disabled parking

U8753/20 Summerfields Road / U8753/30 Springmead

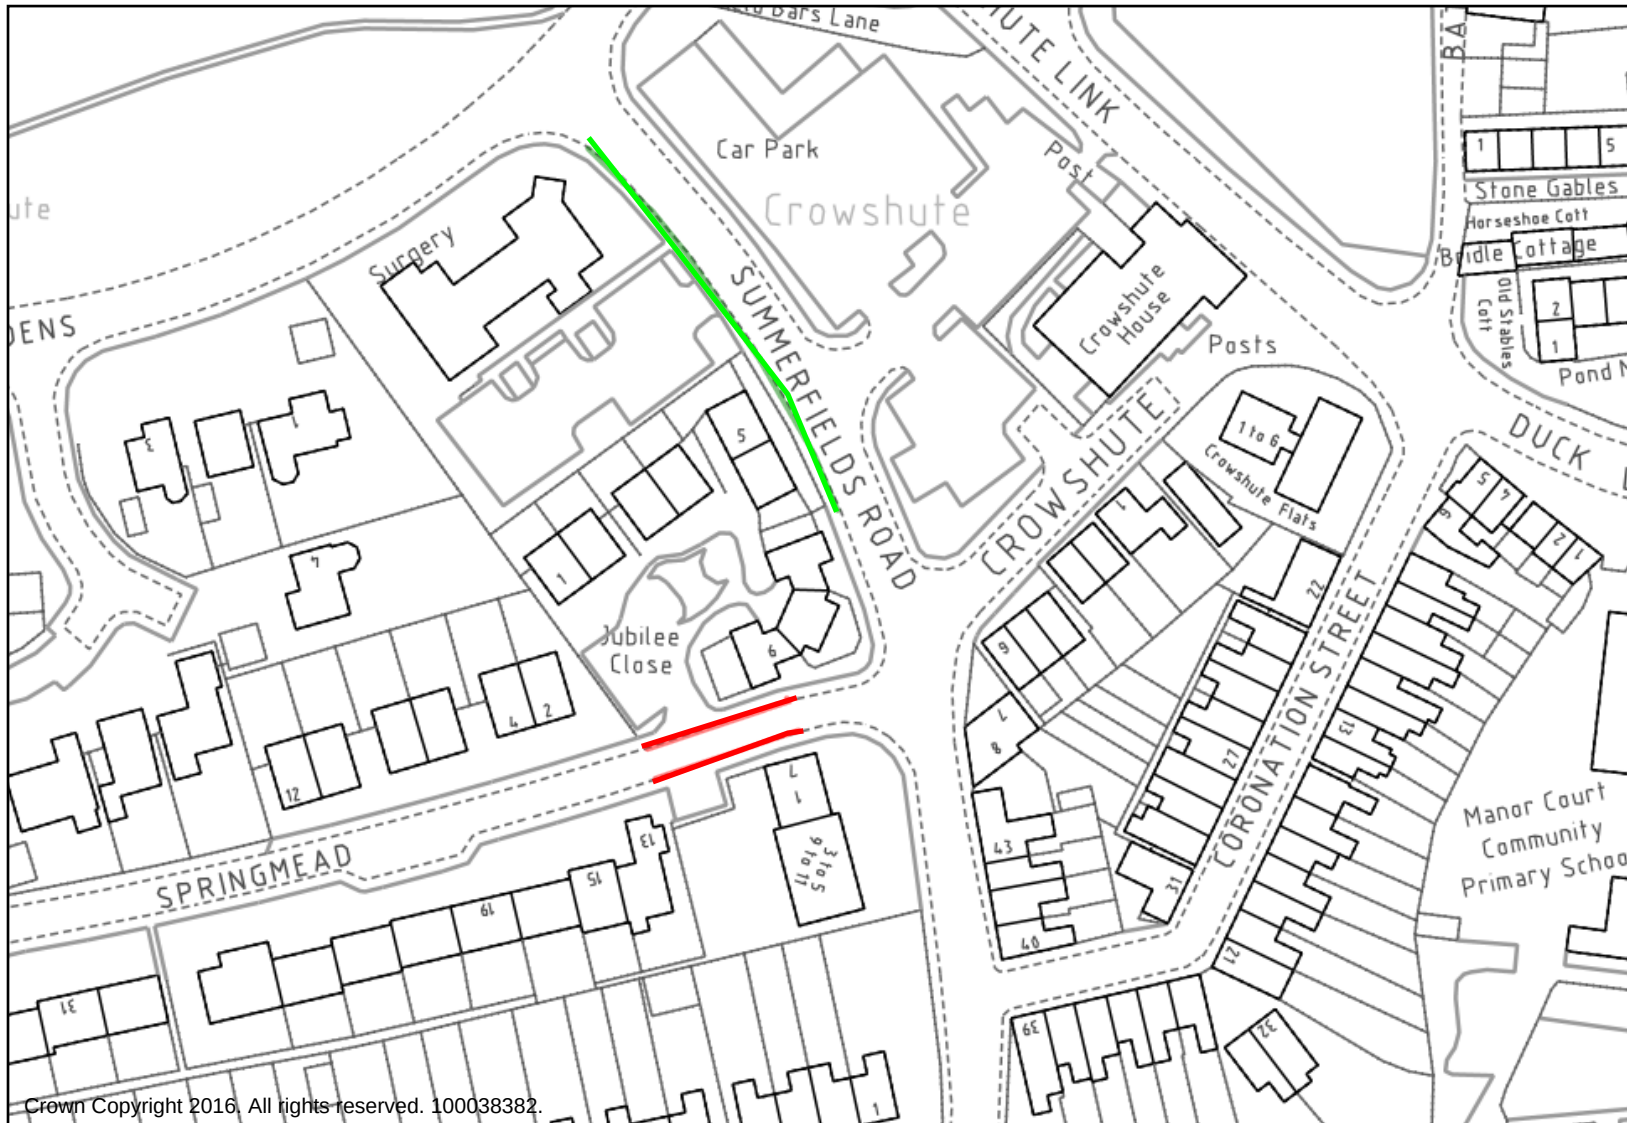

Green Line =
Reinstatement of single
yellow line to reflect signage
Red Line =
Extend double yellow lines
No Waiting At Any Time

A356/210 Market Square Crewkerne and A30/360 East Street/Yeovil Road

Green Lines = No waiting at any time



U5250/10 Kithill Crewkerne




Green Line = No Waiting At Any Time from the end of school zig zag lines

B3168/130 New Road/The Beacon, Iminster



Red Line = introduction of double yellow lines to replace H-Bar and slight extension

U5047/10 and U5047/30 - Court Barton, Ilminster

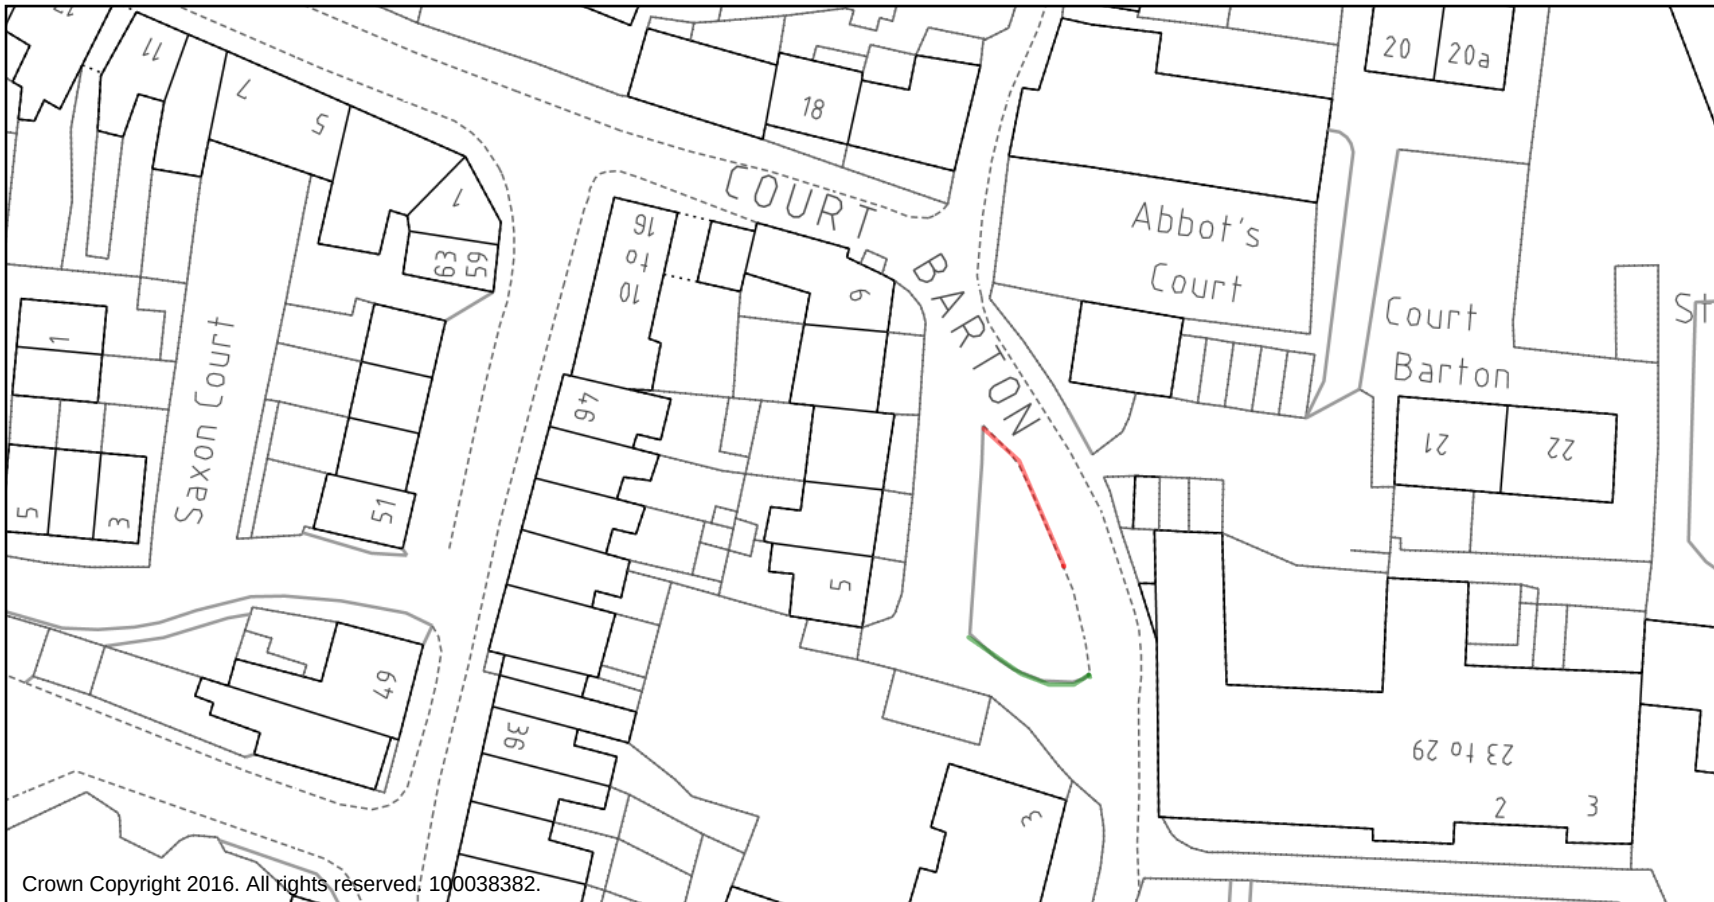

Red Line = Double yellow line
to replace H-Bar
Green Line = Double yellow
lines along this section

T5021/10 West Street, Ilminster




Red Line = remove disabled bay and replace with double yellow lines and extend past vehicular access.

T05017/30 Listers Hill, Ilminster



Red Line = Introduce double yellow lines

T5017/70 East Street, T5017/50 Silver Street and T5312/10 North Street, Ilminster

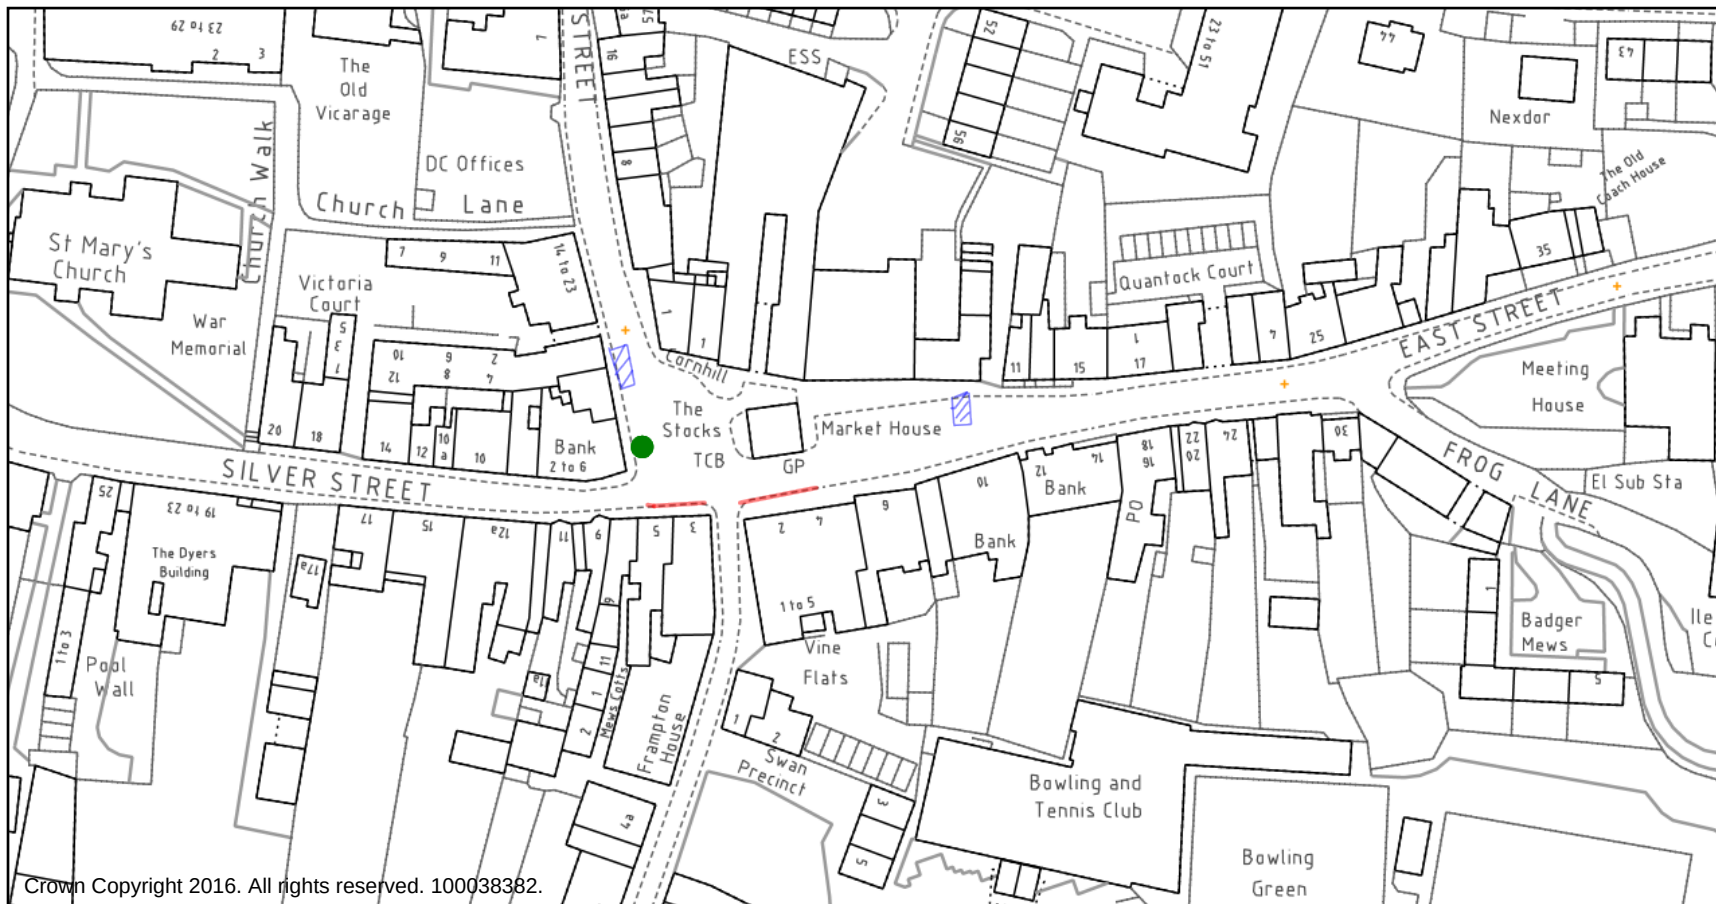

Crown Copyright 2016. All rights reserved. 100038382.

Green circle = change existing disabled bay into a limited waiting
 Red lines = introduce double yellow blips (no loading) to prevent disabled parking or loading
 Blue lines = Lay new disabled parking bays

B3168/130 New Road/The Beacon, Ilminster



Red Line = removal of short section of newly introduced double yellow lines.

B3165/240 - North Street, Martock



Green Line = change to No
Waiting At Any Time
Red Line = Amend Single
Yellow Line to
Mon - Fri 9am - 5pm

B3165/240 - North Street, near Market House, Martock



Green Line = No Waiting at Any Time

U5039/20 Bonnies Lane, Stoke Sub Hamdon




Red Line = West side revoke
5 metres southwards to High Street

T5503/60 Ham Hill Road, Stoke Sub Hamdon



Black line = Revocation of existing restriction

T8520/10 - West Street, Stoke Sub Hamdon

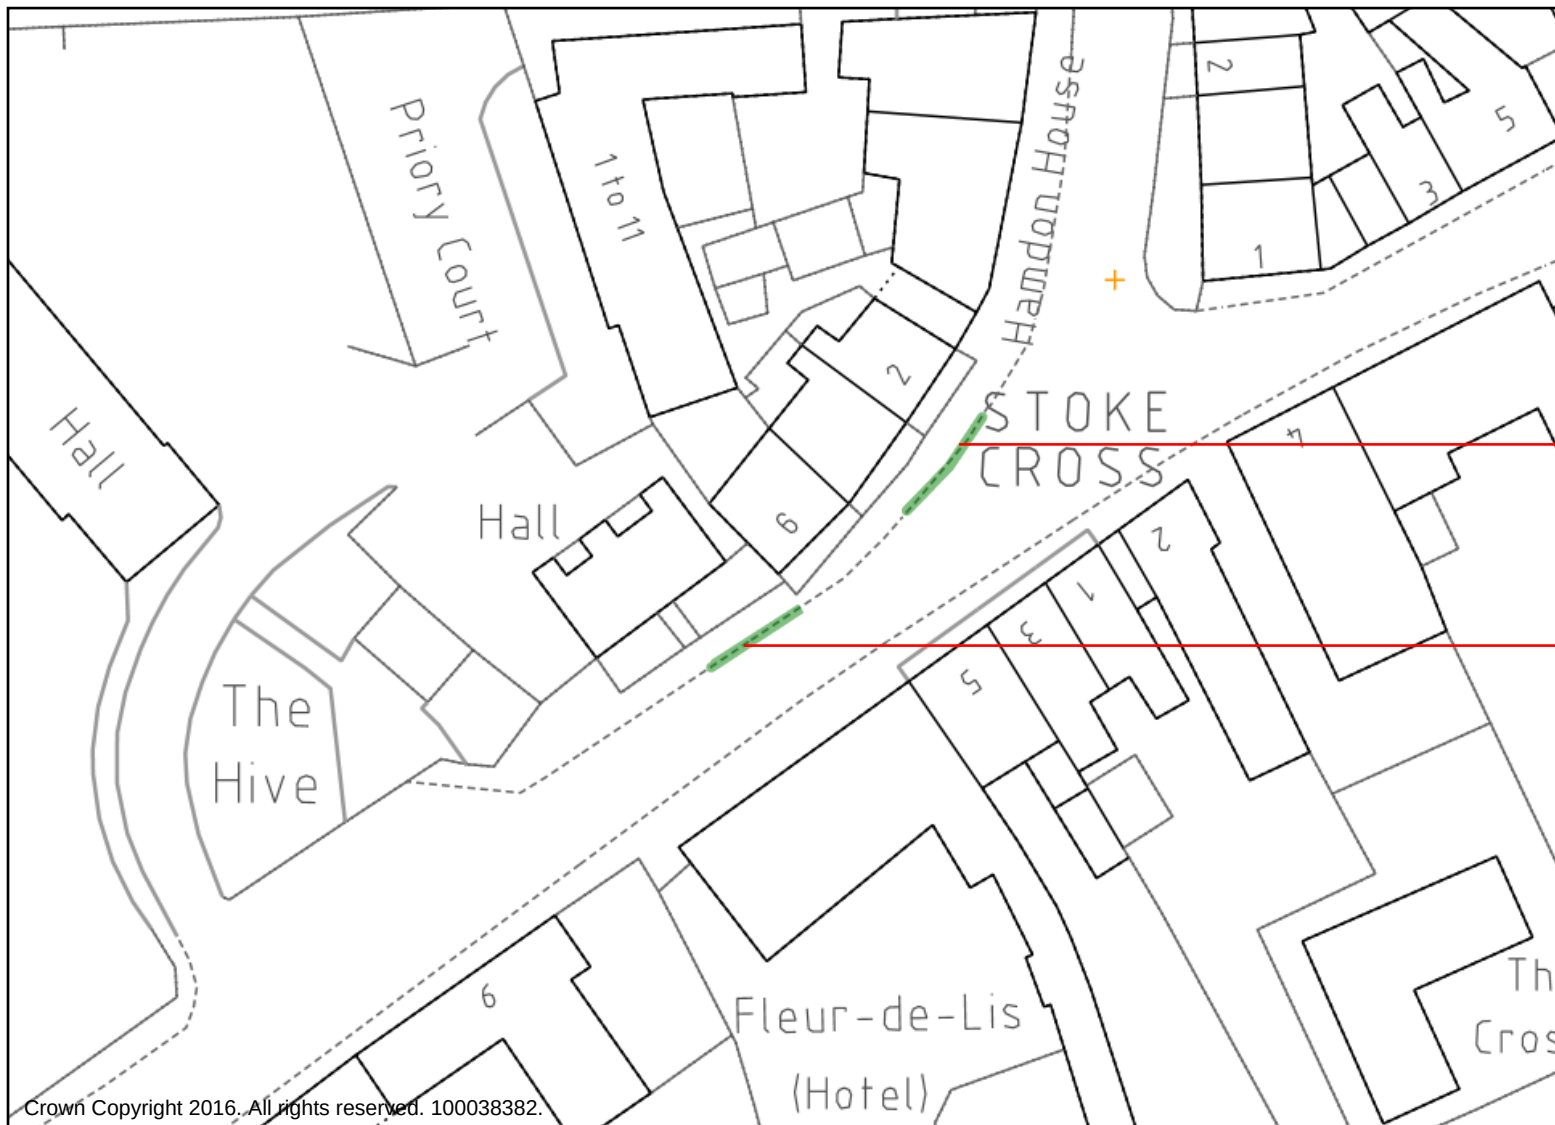


Green Lines = Revocation of No Waiting
At Any Time

Revoke 22.5 metres

Revoke 5 metres

U5958/10 Balsam Fields, Wincanton

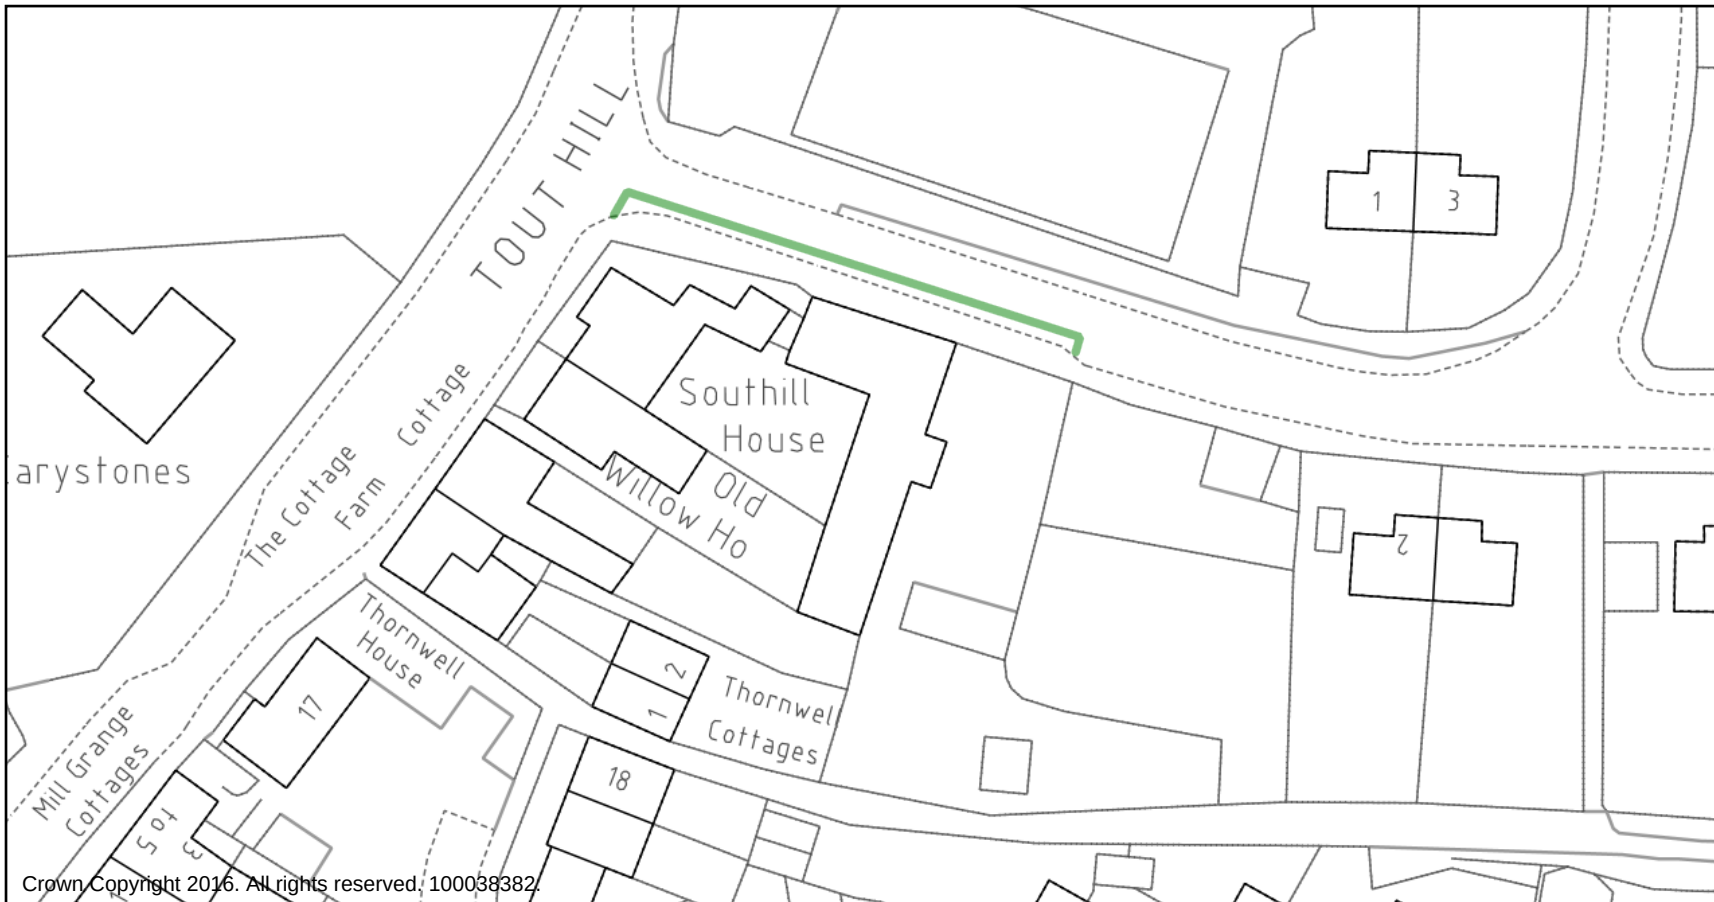


Green Line = No Waiting At Any Time

B3081/325 - Church Street and U5951/10 Mill Street, Wincanton



Green Line = Revoke Limited Waiting
and introduce No Waiting At Any
Time for 2 parking spaces
Black Circle = change to read from
8am to 6pm

U8525/10 - Lupin Way, Yeovil

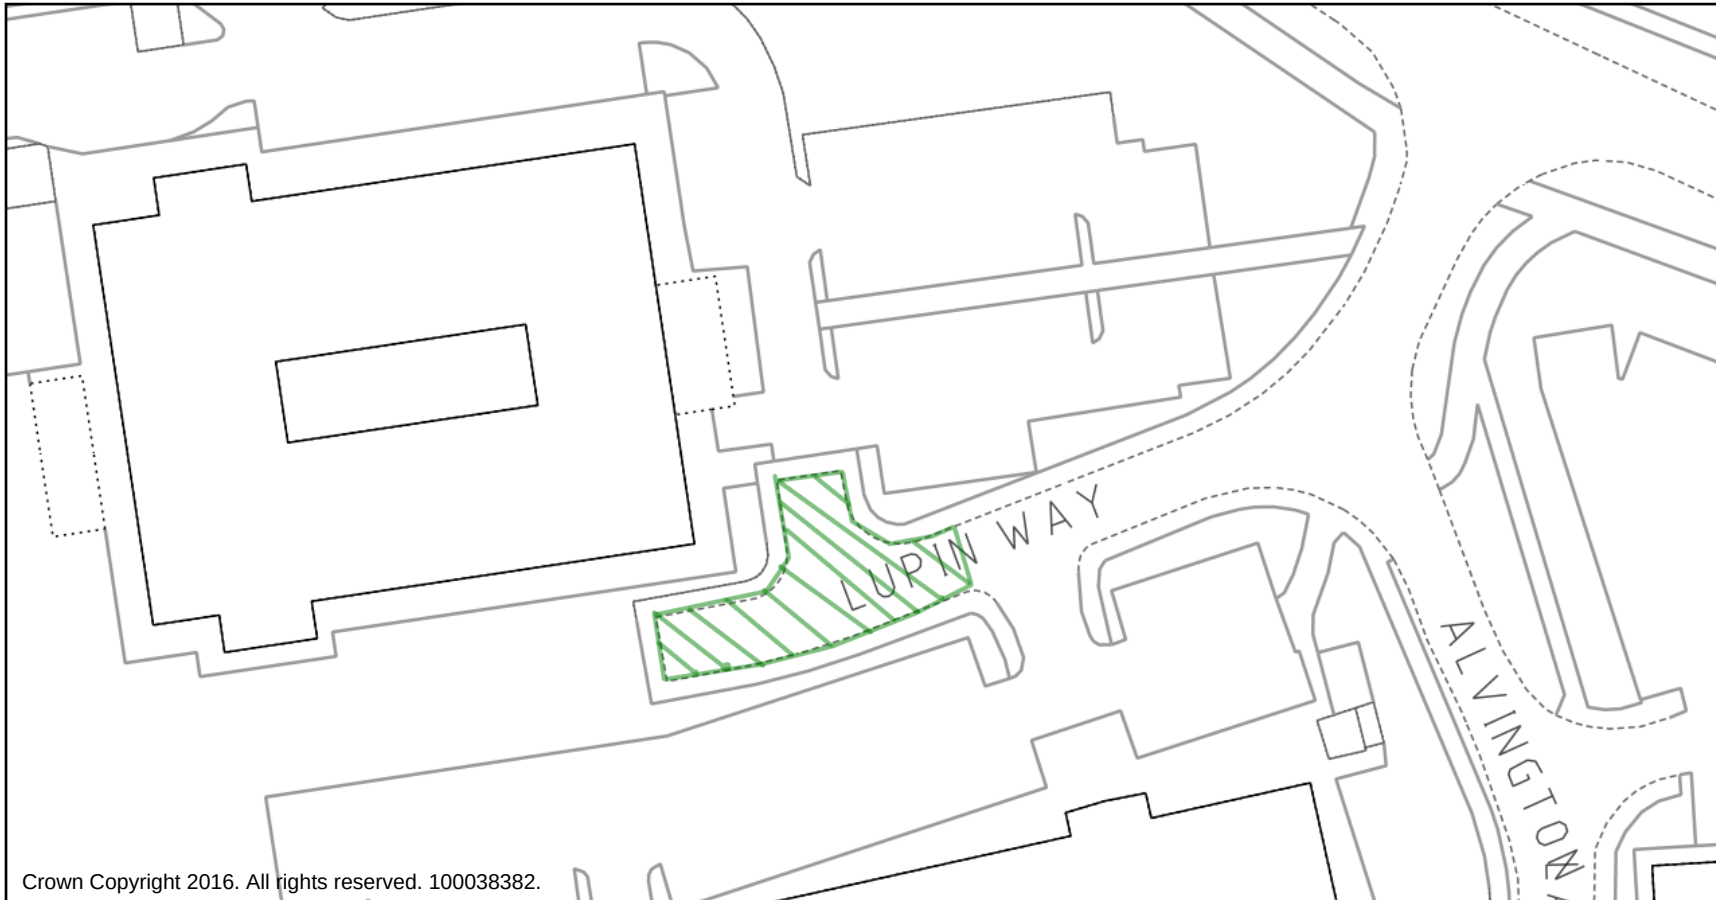

Green Lines =
No Waiting At Any Time

A359/110 Mudford Road, Yeovil




Green Lines = Extend existing
No Waiting At Any Time

U8202/10 Alastair Drive, Yeovil




Green Lines = No Waiting At Any Time

U8156/70 - Birchfield School Road, Yeovil

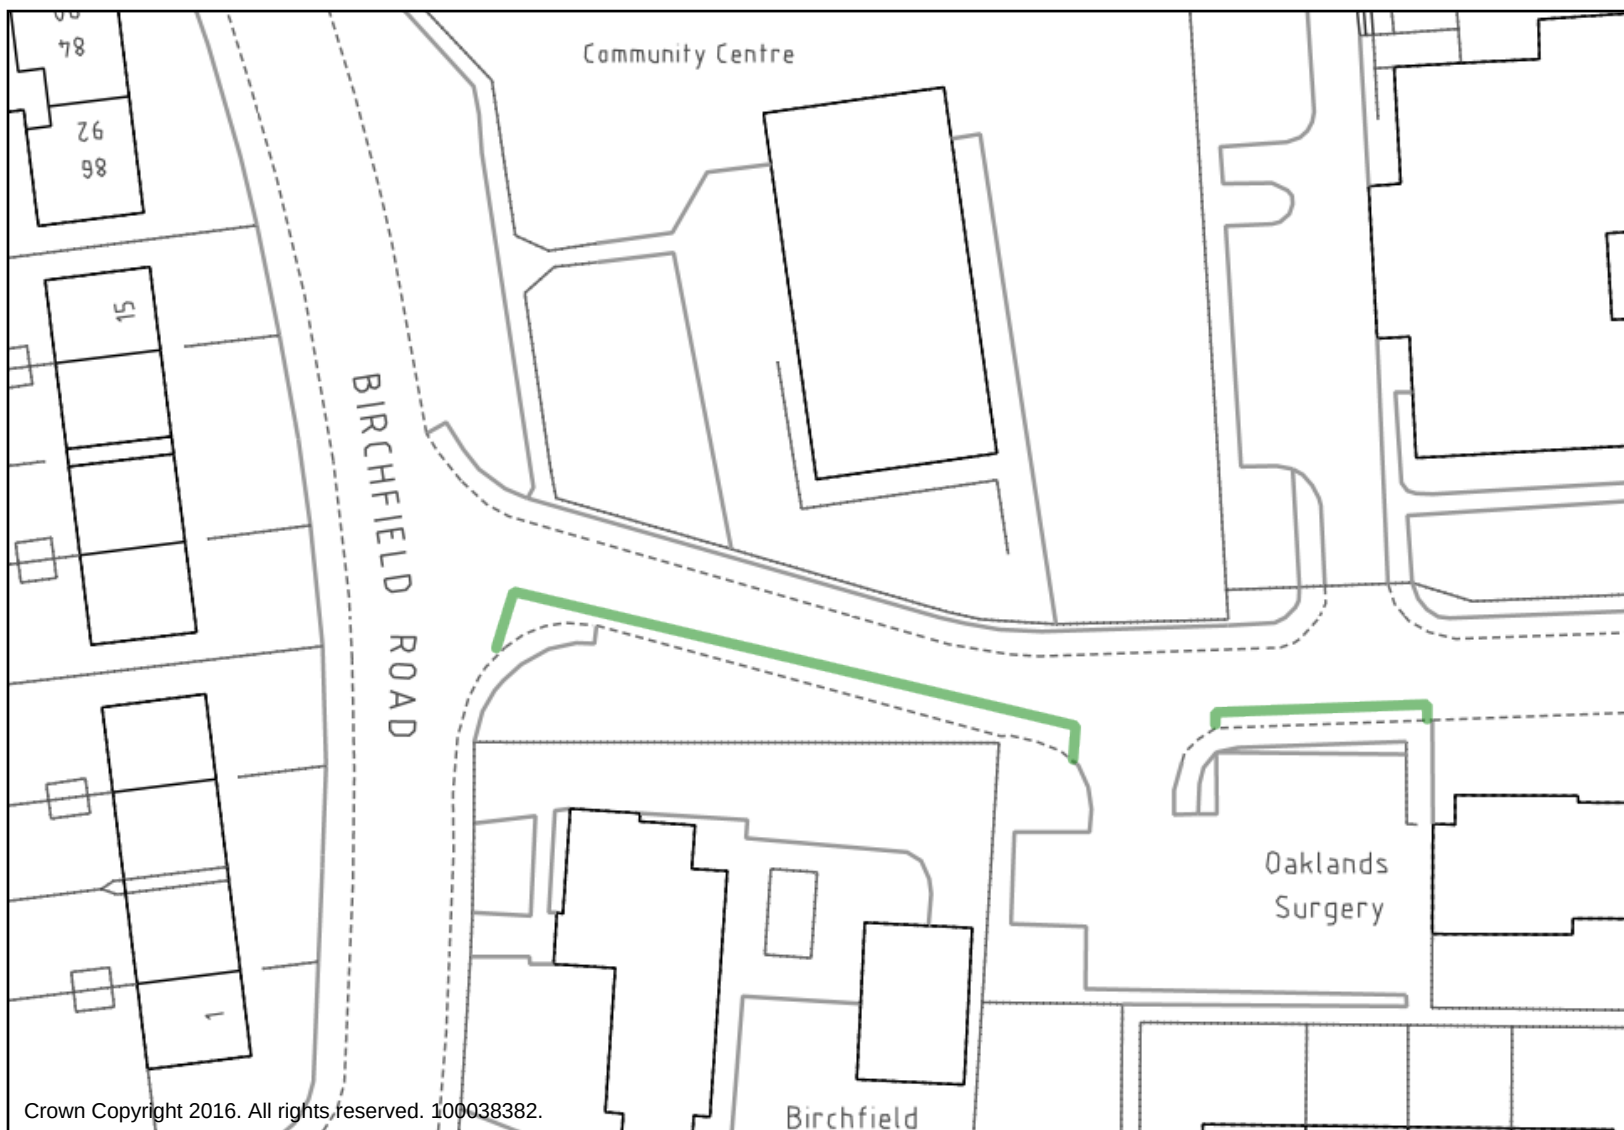


Green Line = No Waiting At Any Time

U9428/10 Boundary Way, Yeovil

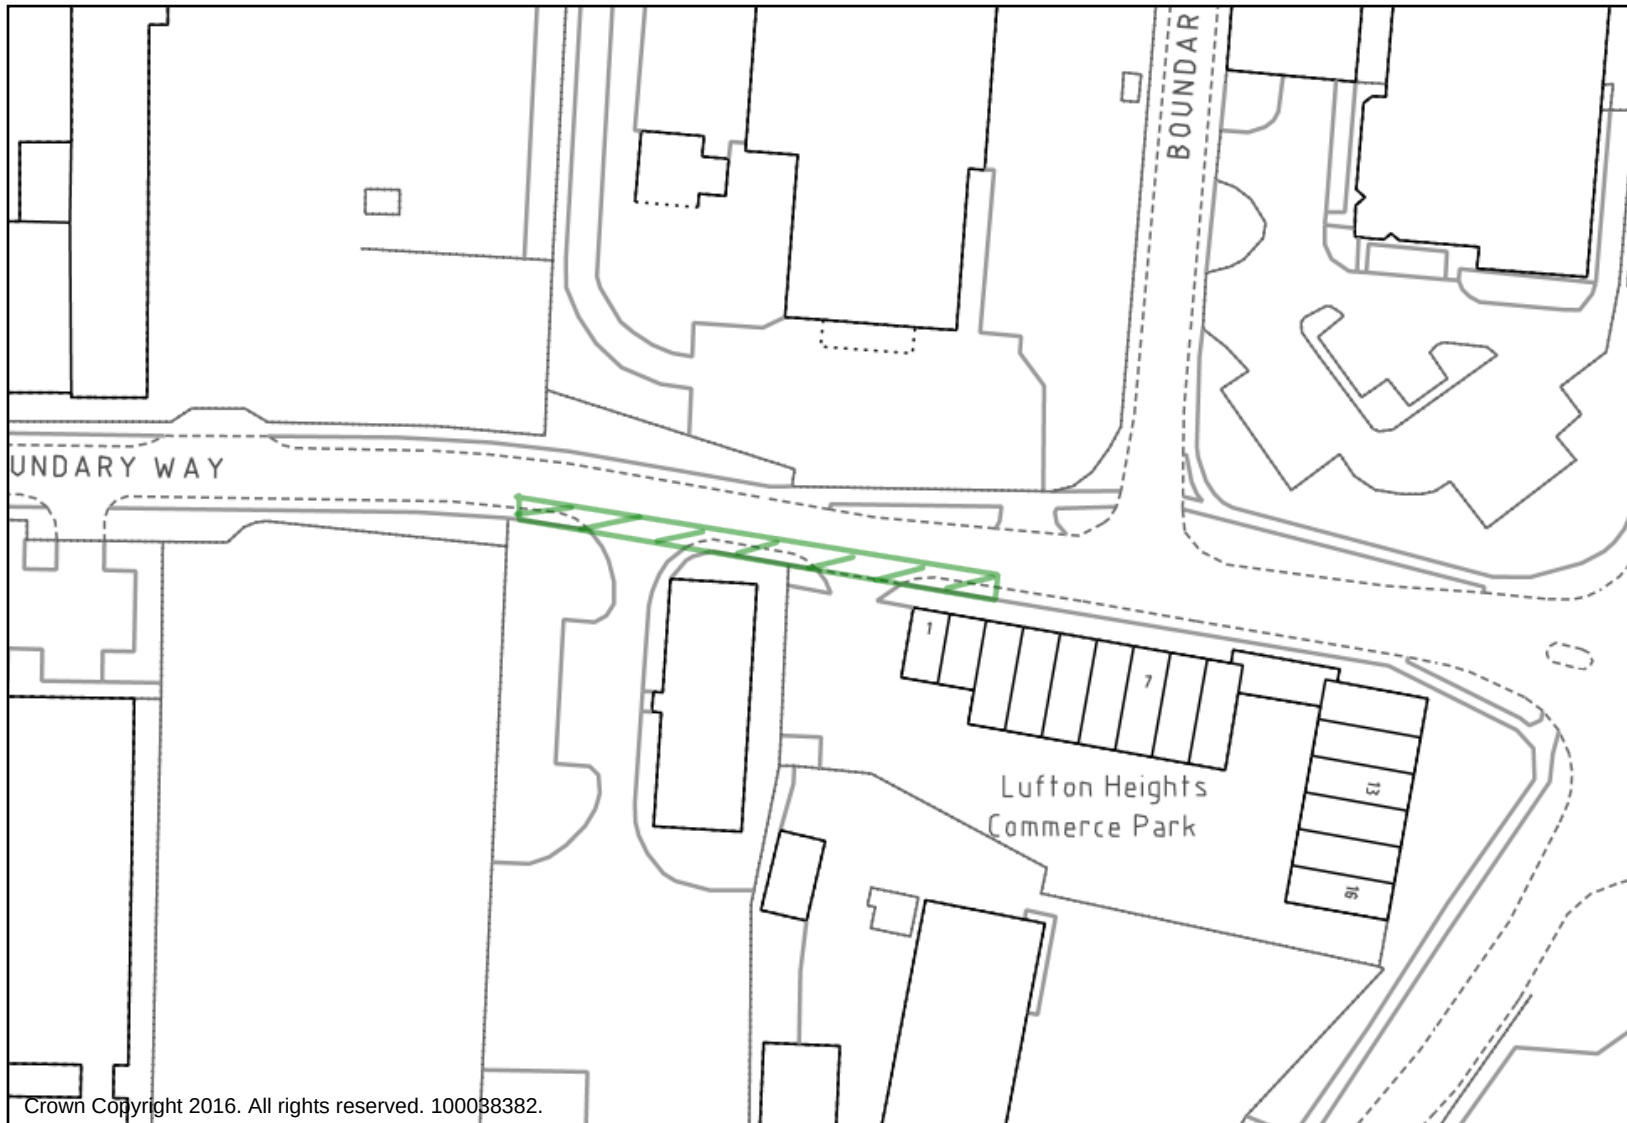

Green Line = No Waiting At Any Time

U8214/30, U8214/10 - Carisbrooke Gardens, Yeovil

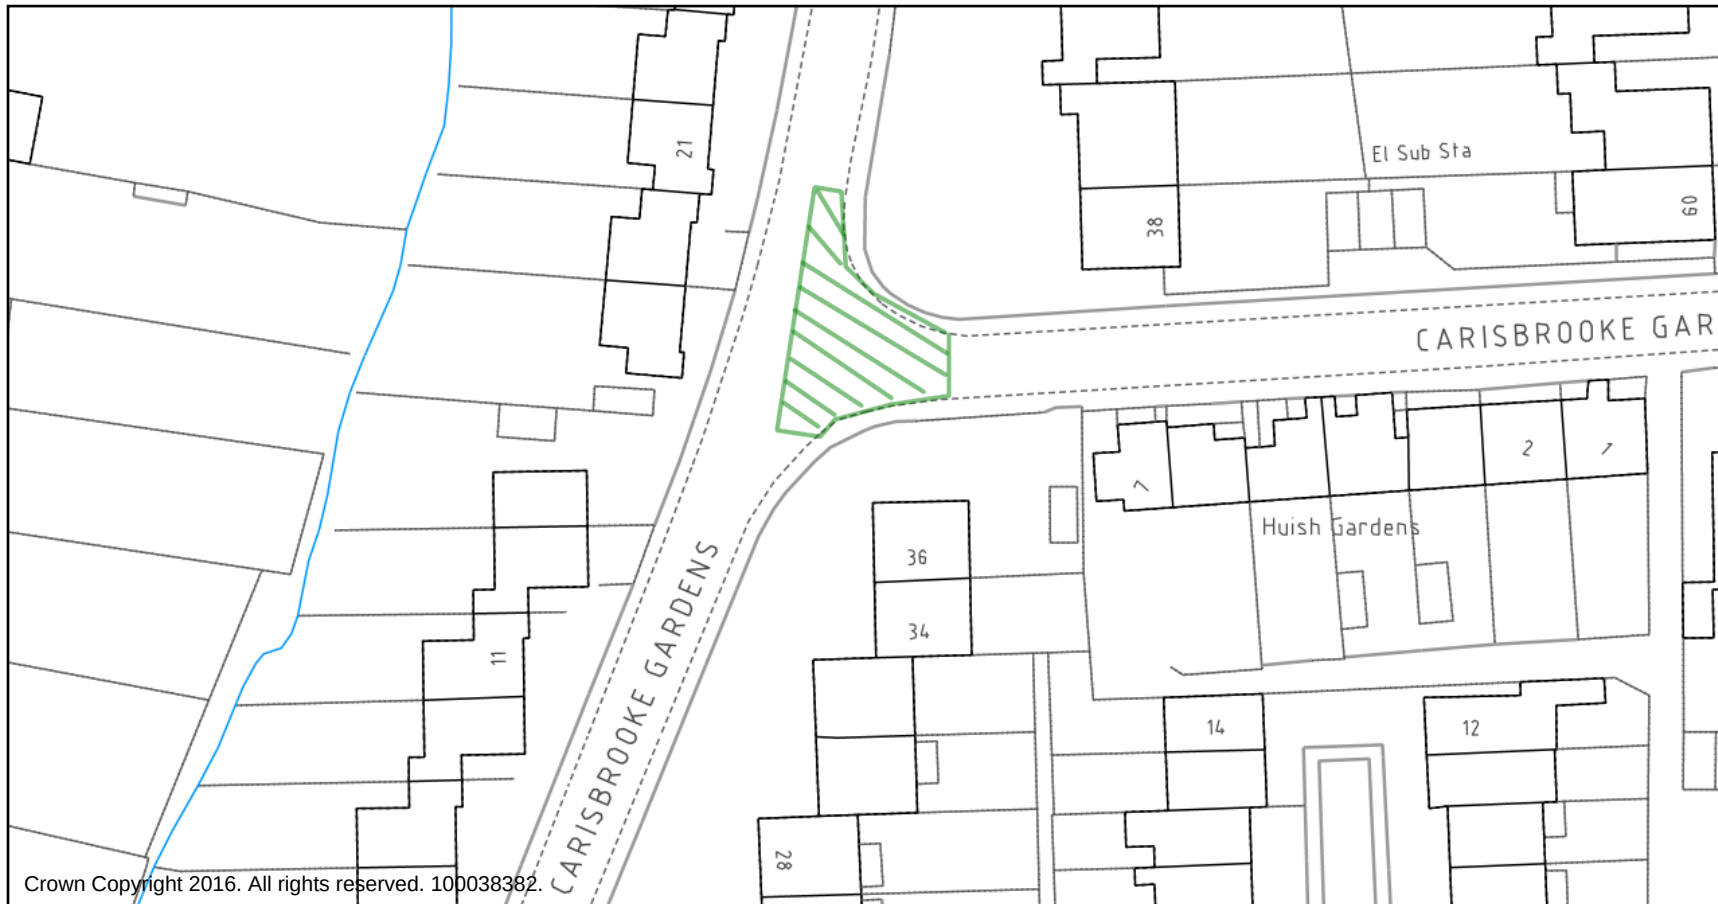

Green Lines =
No Waiting At Any Time

U9372/10 - College Green, Yeovil



Green Lines = Change White Lines to
No Waiting At Any Time

U8225/10 - Brympton Way, Yeovil



Red Line = Revoke existing No Waiting
At Any Time

U8115/10 - Glenthorne Avenue, Yeovil



Green Lines = No Waiting At Any Time

U8102/10, U9372/10 - Goldcroft, Yeovil




Green Lines = Change White
Lining to No Waiting At Any
Time

U8183/10 Monks Dale, Yeovil




Red Line = Existing No Waiting At Any Time.
Blue Line = Extend existing Restriction

U8477/150 - Muchelney Way, Yeovil

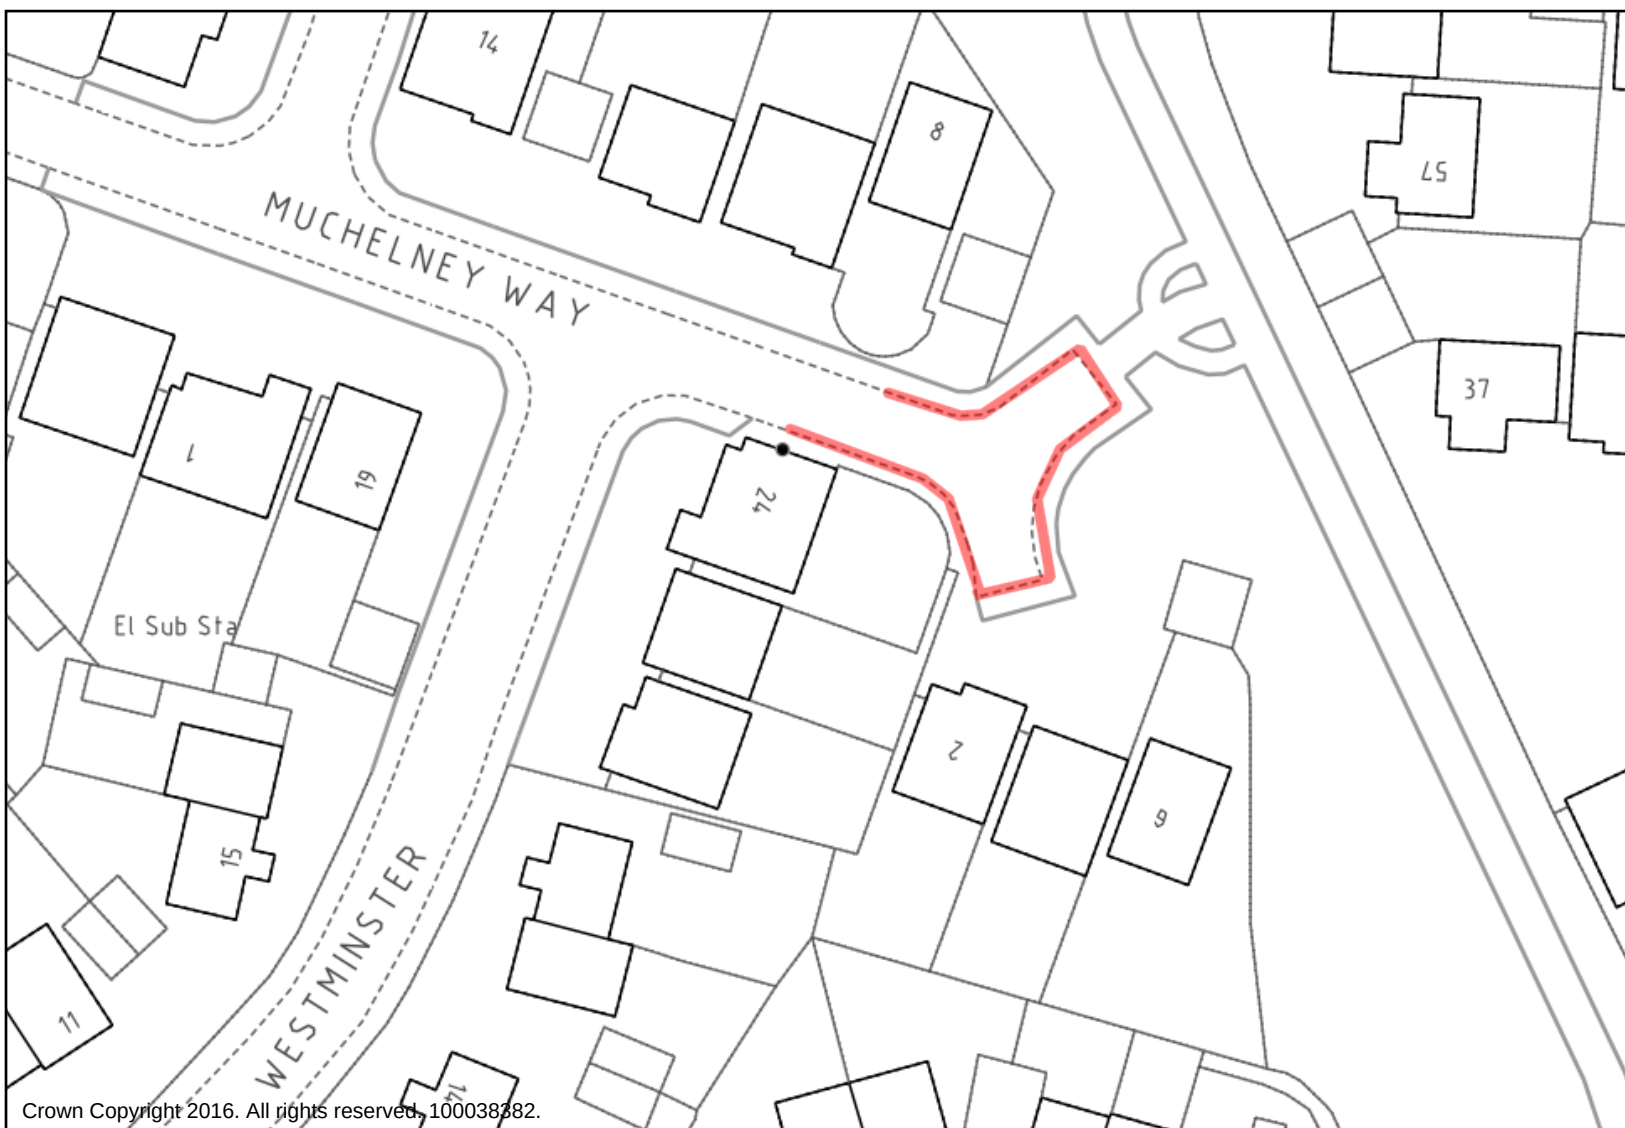


Red Line = removal of double yellow
lines to lamp column
Black dot = lamp column

U9459/10 - Preston Road (known as Old Preston Road)

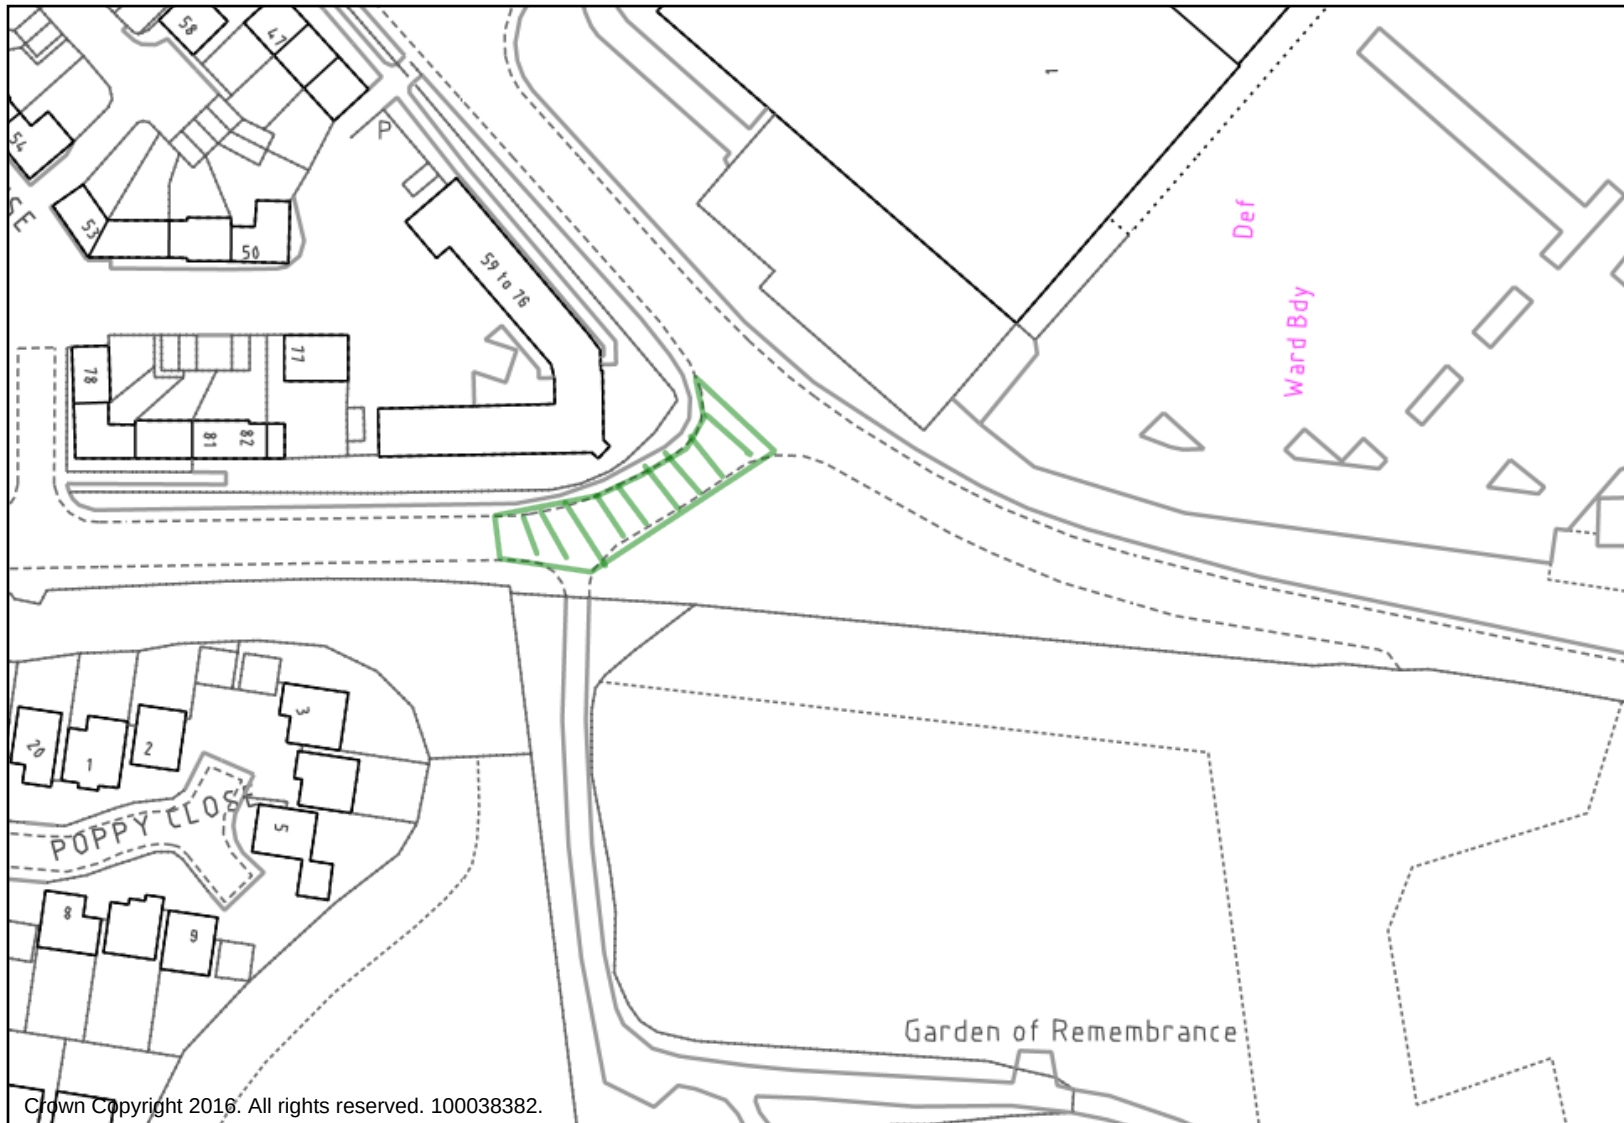


Green area = No Waiting at Any Time

U8170/10 - St James Close, Yeovil

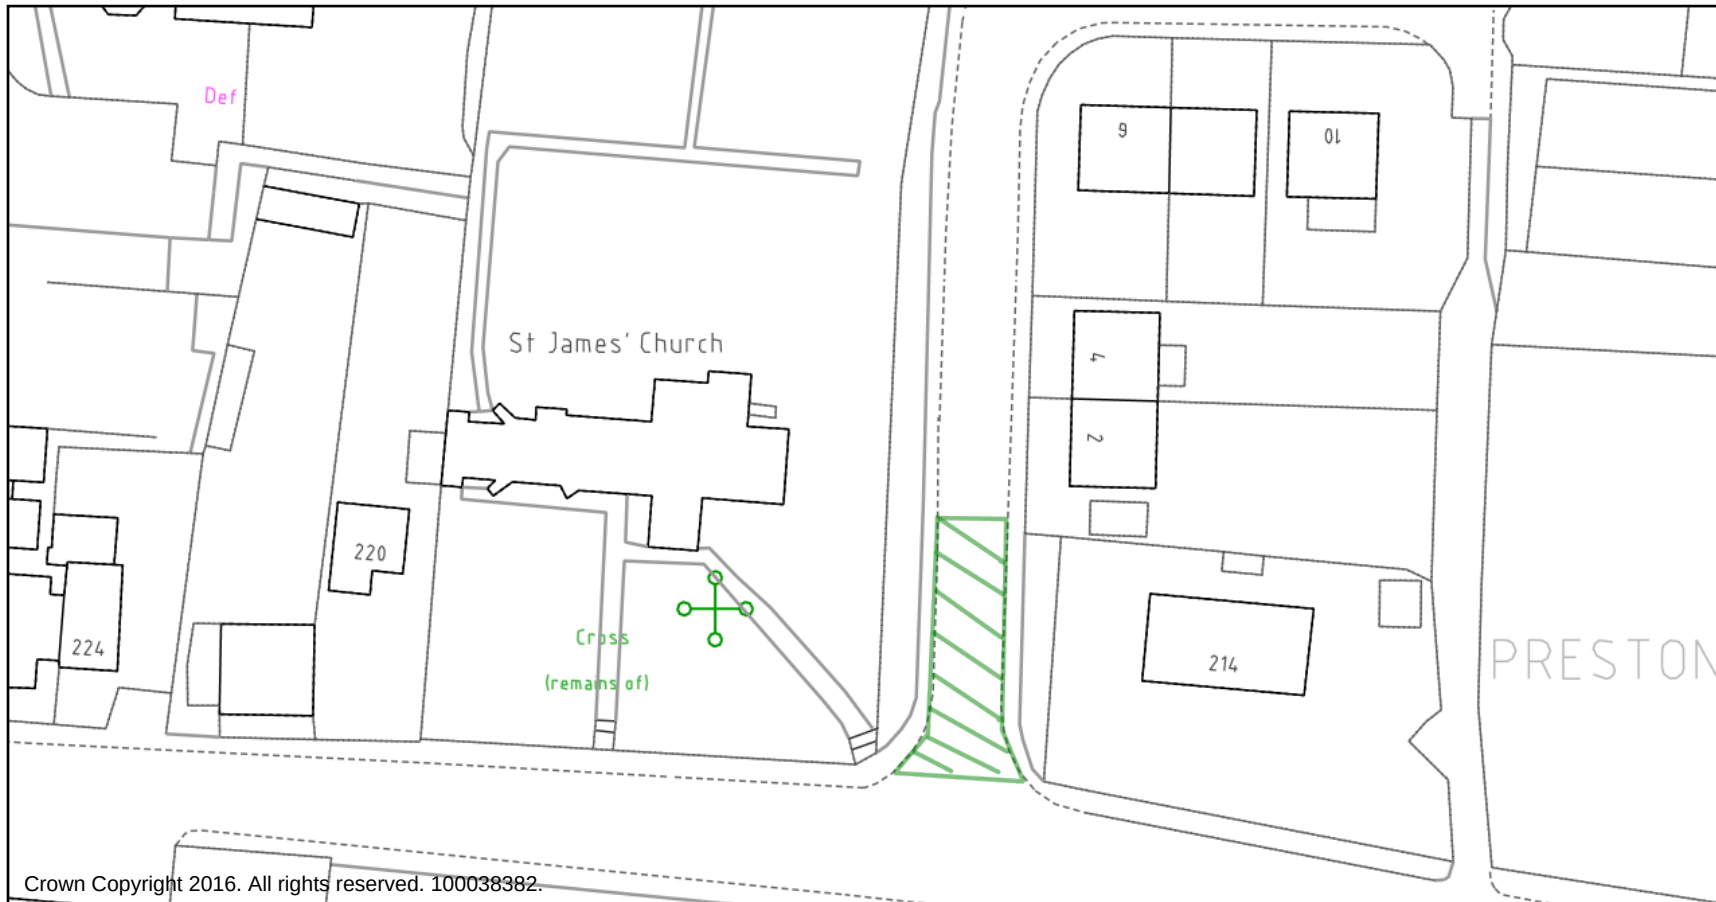


Green Lines =
No Waiting At Any Time

U9162/30 - Tower Road, Yeovil

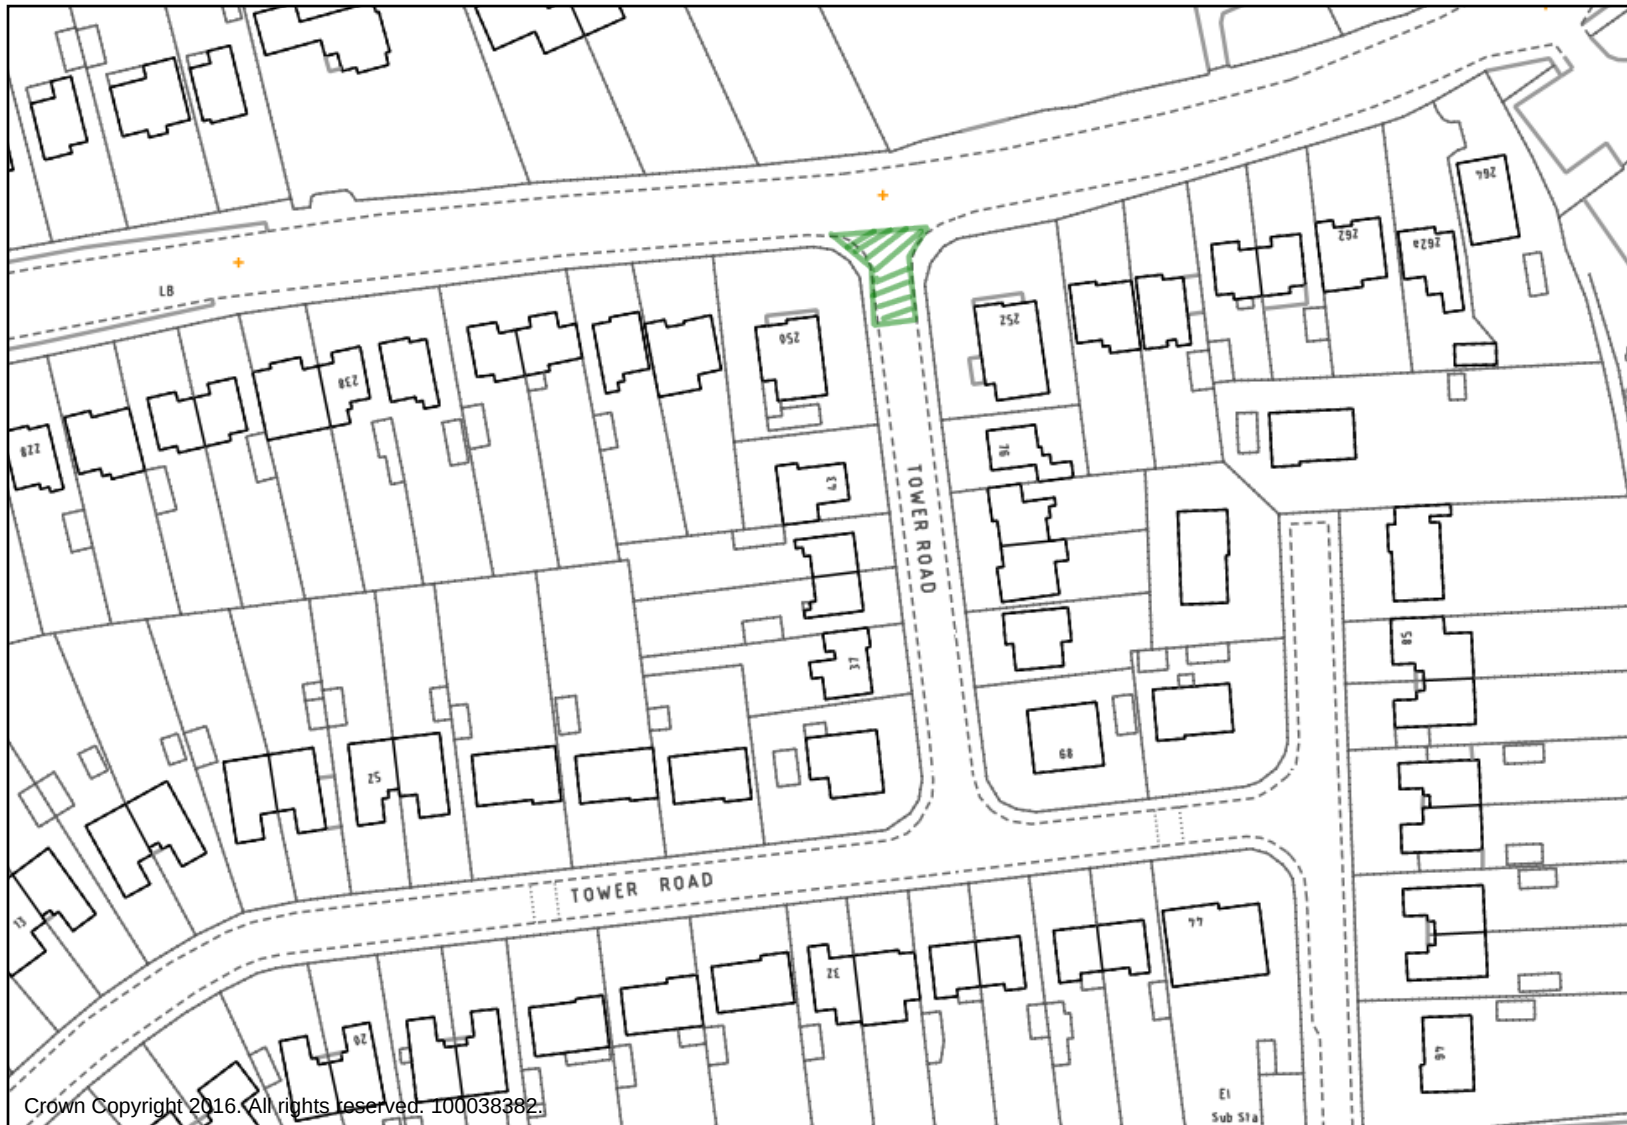

U8103/11 - Sparrow Road, Yeovil

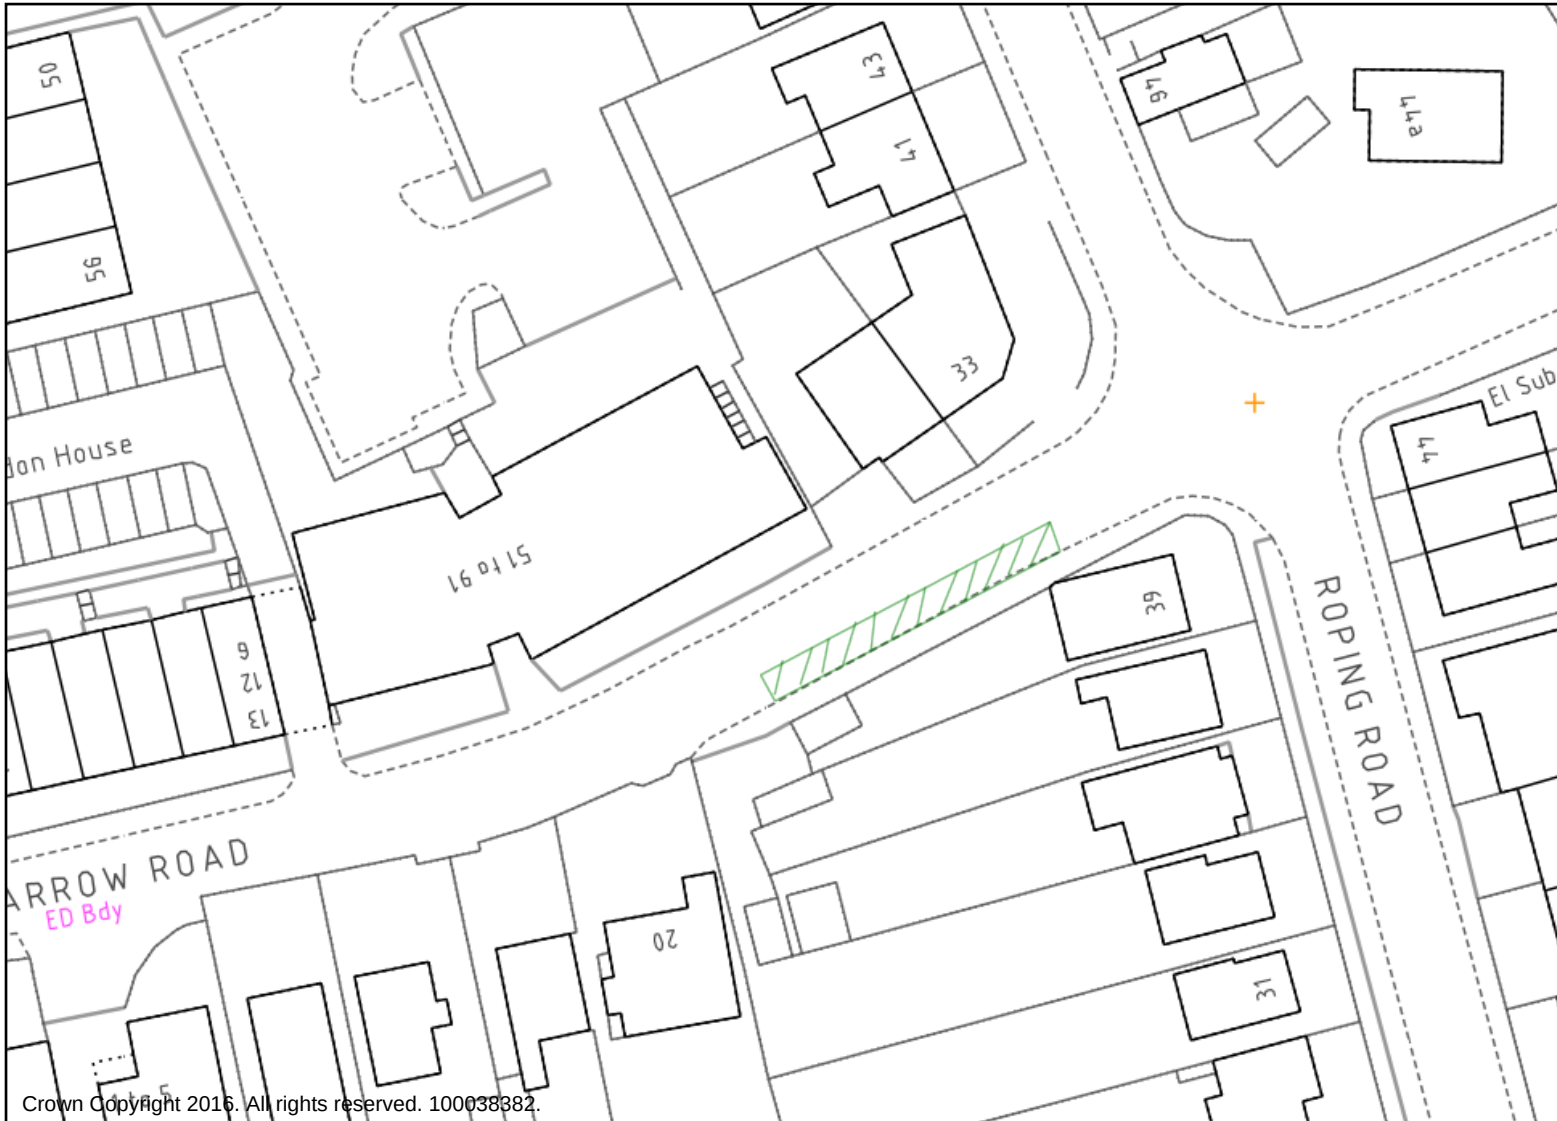

Green Line = Extend No Waiting At Any Time




SOMERSET COUNTY COUNCIL
intranet MAPPING

U8215/75 West Street, Yeovil - New Double
Yellow Lines


Scale - 1:892.813

Easting: 354904, Northing: 115910

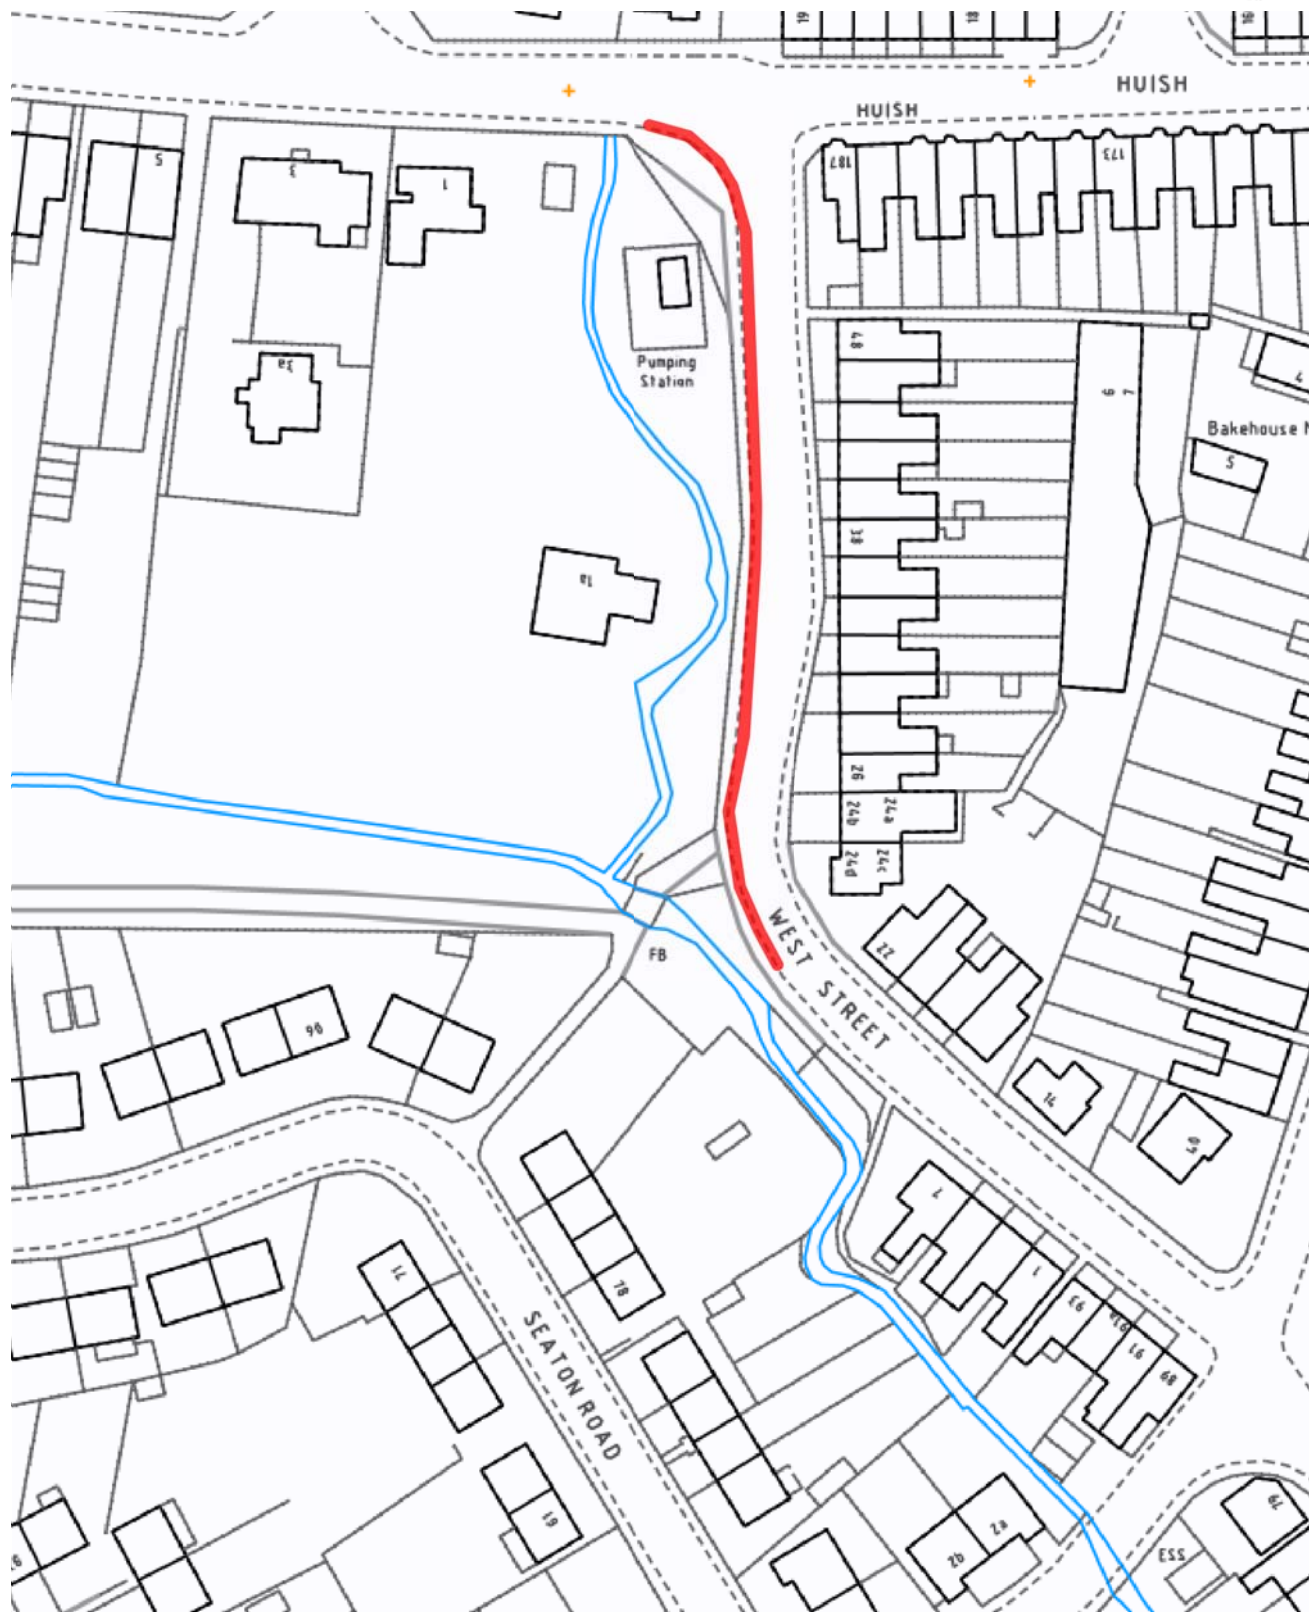

Somerset County Council 100038382 (2016) Crown Copyright


Bradford's Yard, Betterment Development, Misterton

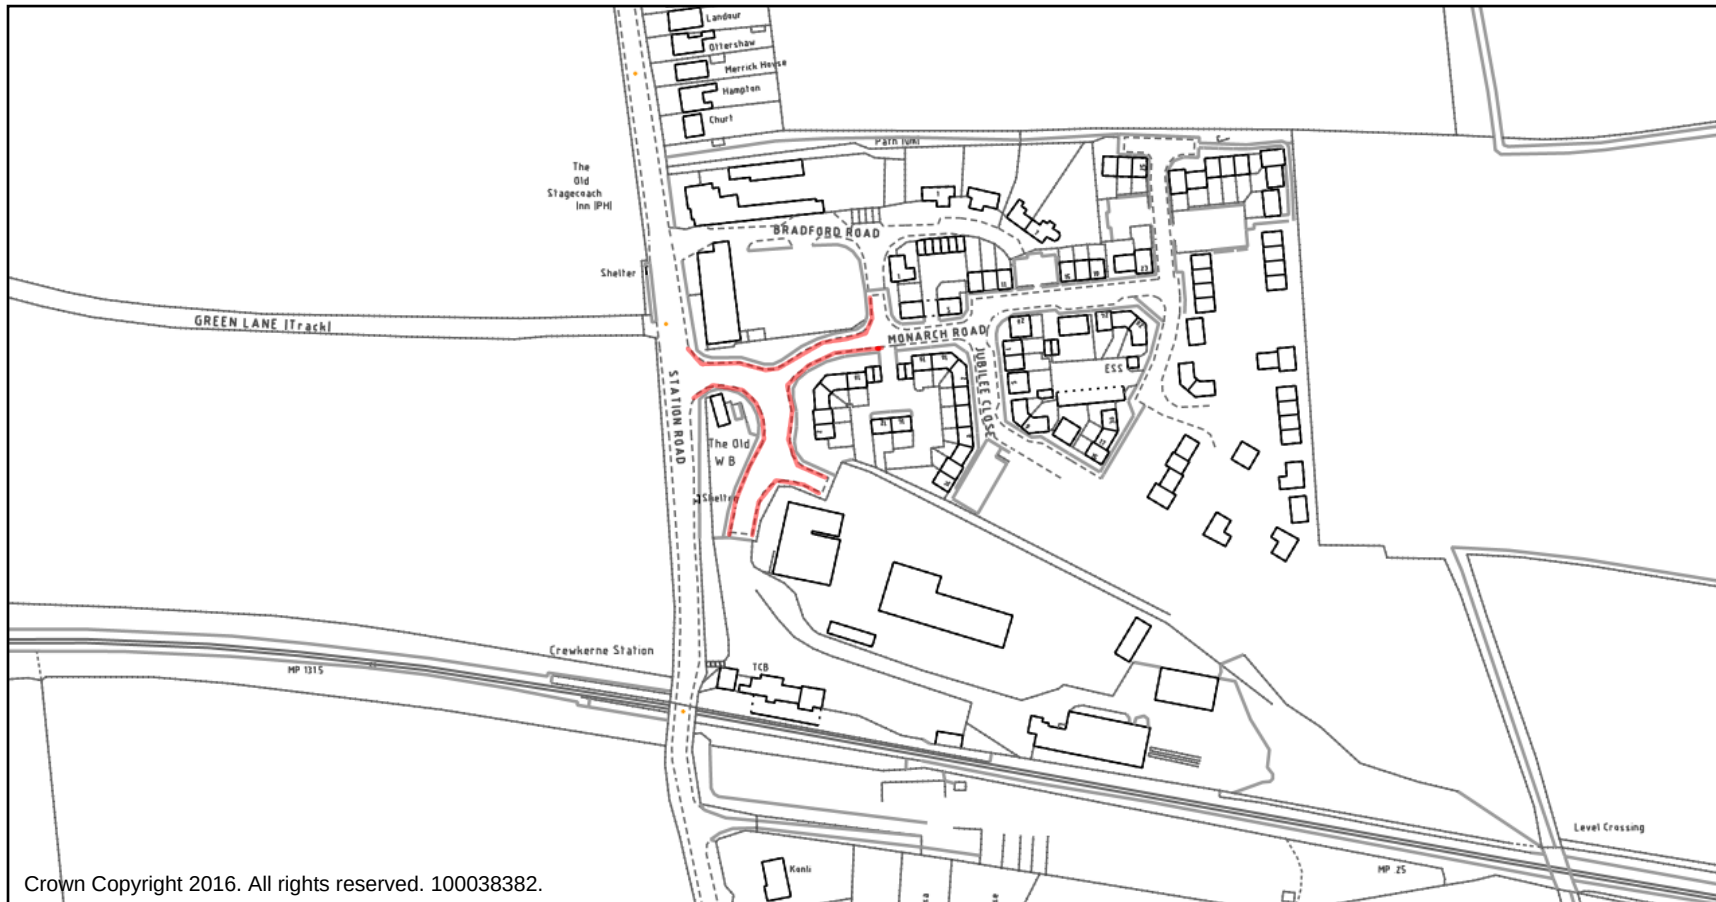

Red Line = lay new Double
Yellow Lines

Five Dials, Horton


T5323/10 Goose Lane, T5019/20 Hanning Road, T5304/10 Pound Road and T5019/10 Broadway Hill

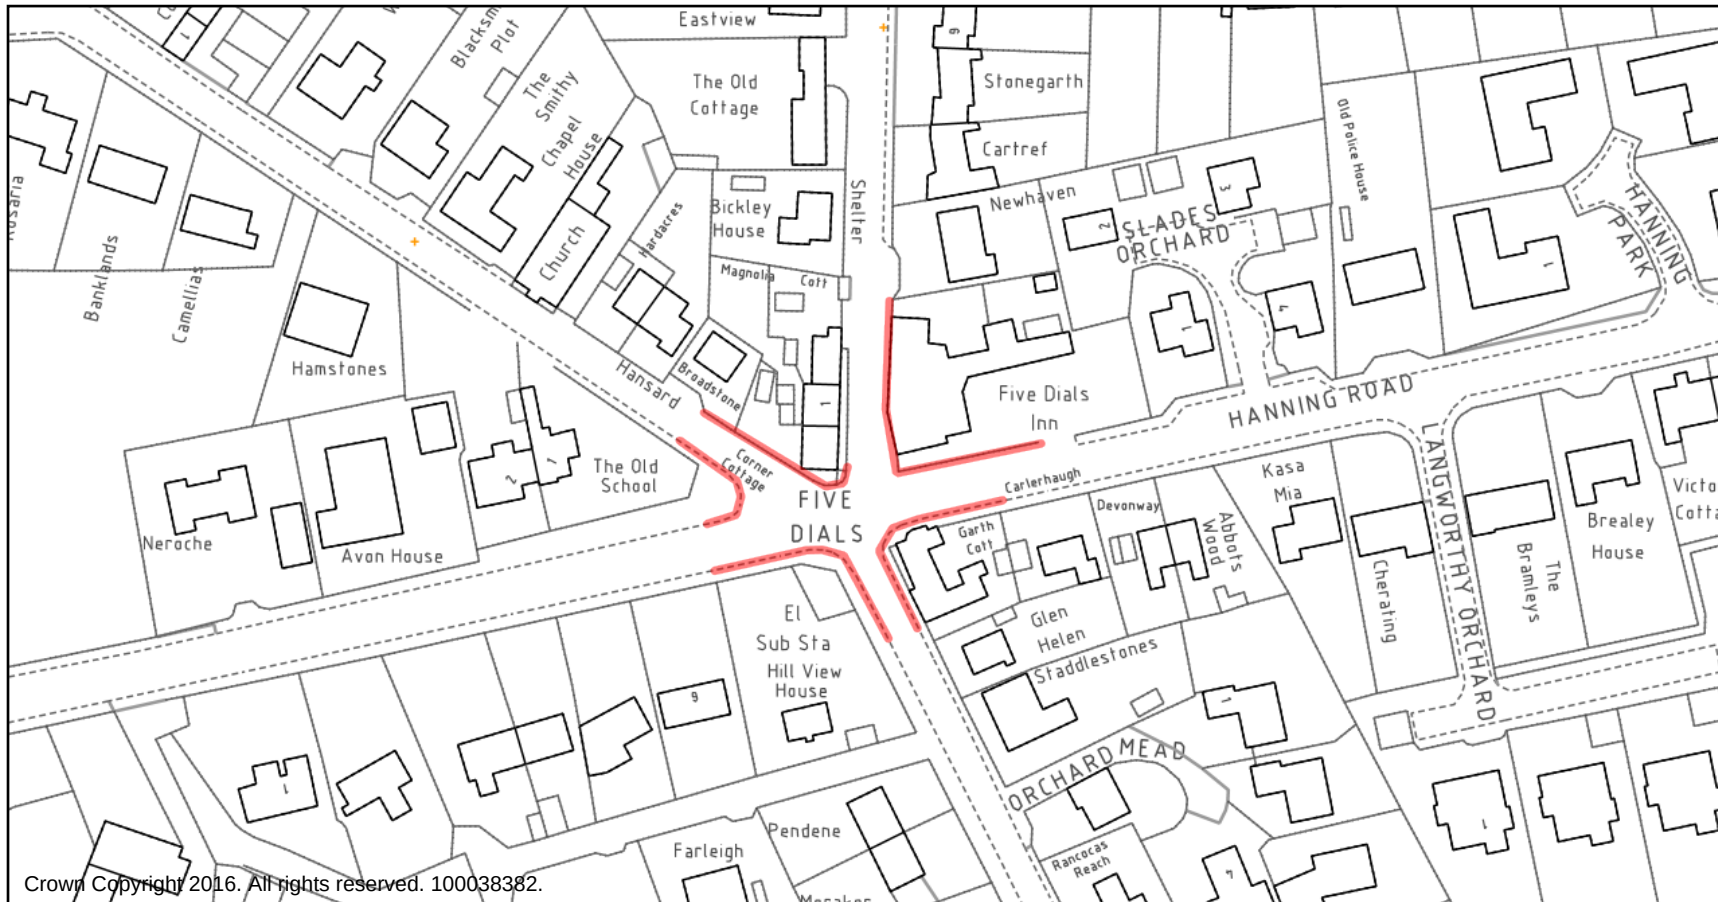

Red Lines = New double yellow lines

South Petherton Village Centre

T5442/30, T5483/60 St James Street, T5443/50, T5443/60 Market Square and T5443/40 The Parade

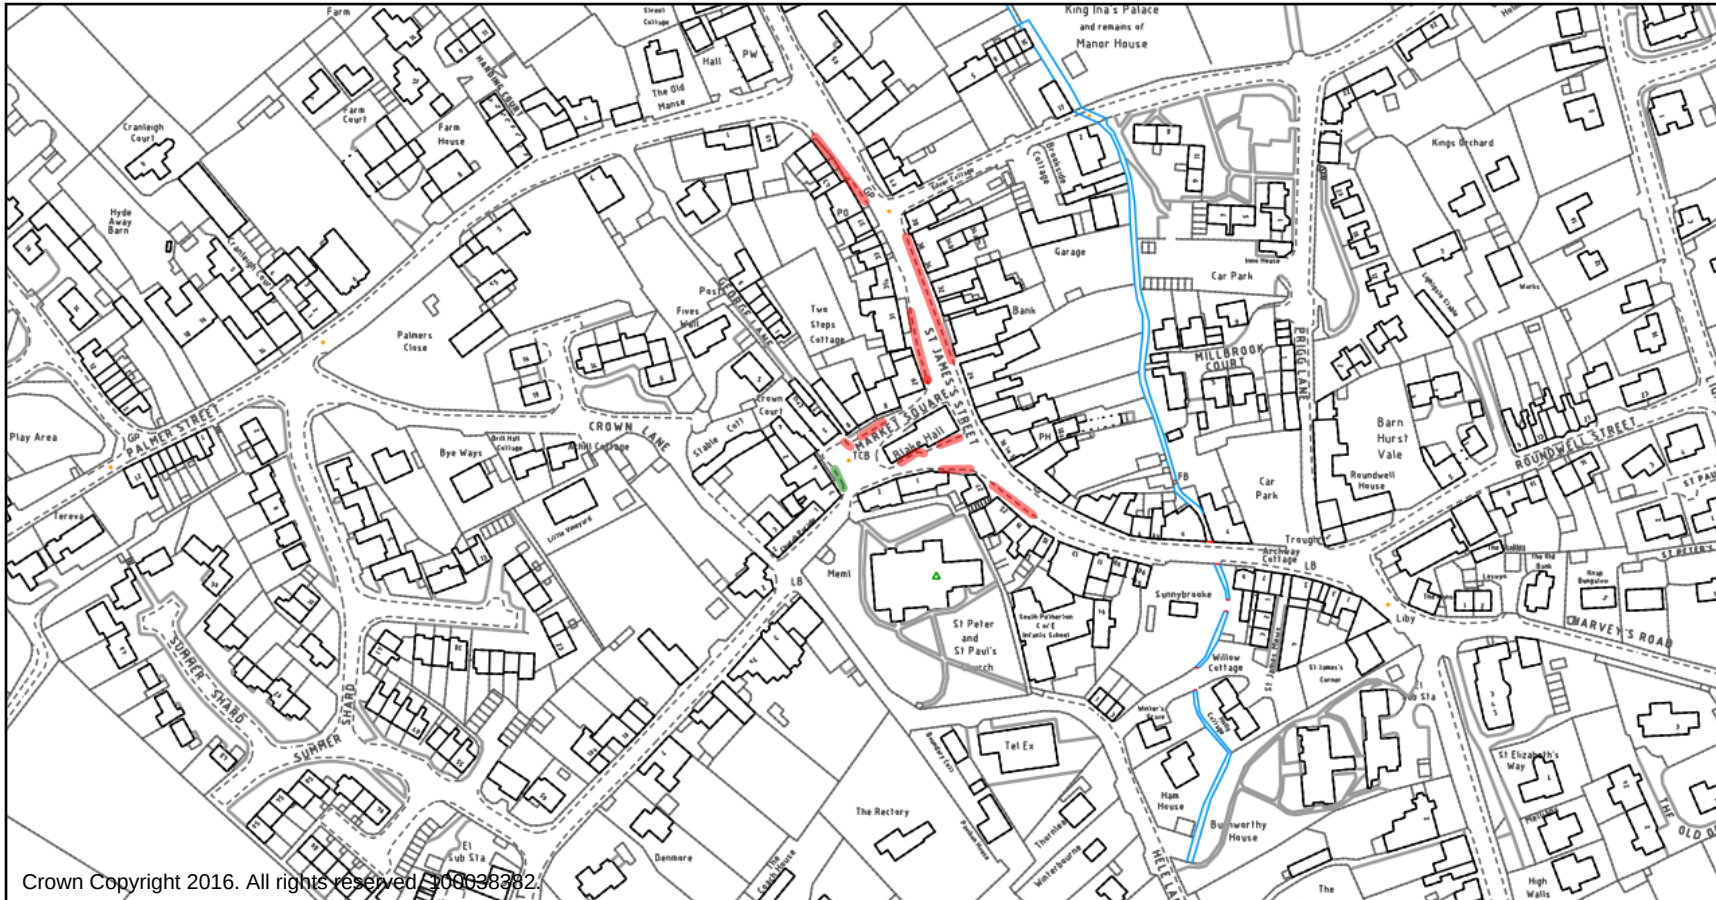

Crown Copyright 2016. All rights reserved. 900938382.

Red Lines = amend all
Limited Waiting to allow
2 hour/1 hour
Green Line = New disabled
bay