



SOMERSET COUNTY COUNCIL
intranet MAPPING

CHANDOS STREET, BRIDGWATER - REPLACE SYL WITH NWAAT

Scale - 1:892.813

Easting: 329944, Northing: 137250

Introduce No Waiting At Any Time -
Double Yellow Lines as shown in red



Somerset County Council 100038382 (2017) Crown Copyright



SOMERSET COUNTY COUNCIL
intranet MAPPING


CHILTON STREET/SALTLANDS - NWAAT. ALL OTHER TO BE REVOKED.

Scale - 1:1,785.626

Easting: 329808, Northing: 138049

Revoke Single
Yellow Line
Restrictions in
Chilton Street

Introduce No Waiting At
Any Time - Double Yellow
Lines as shown in red

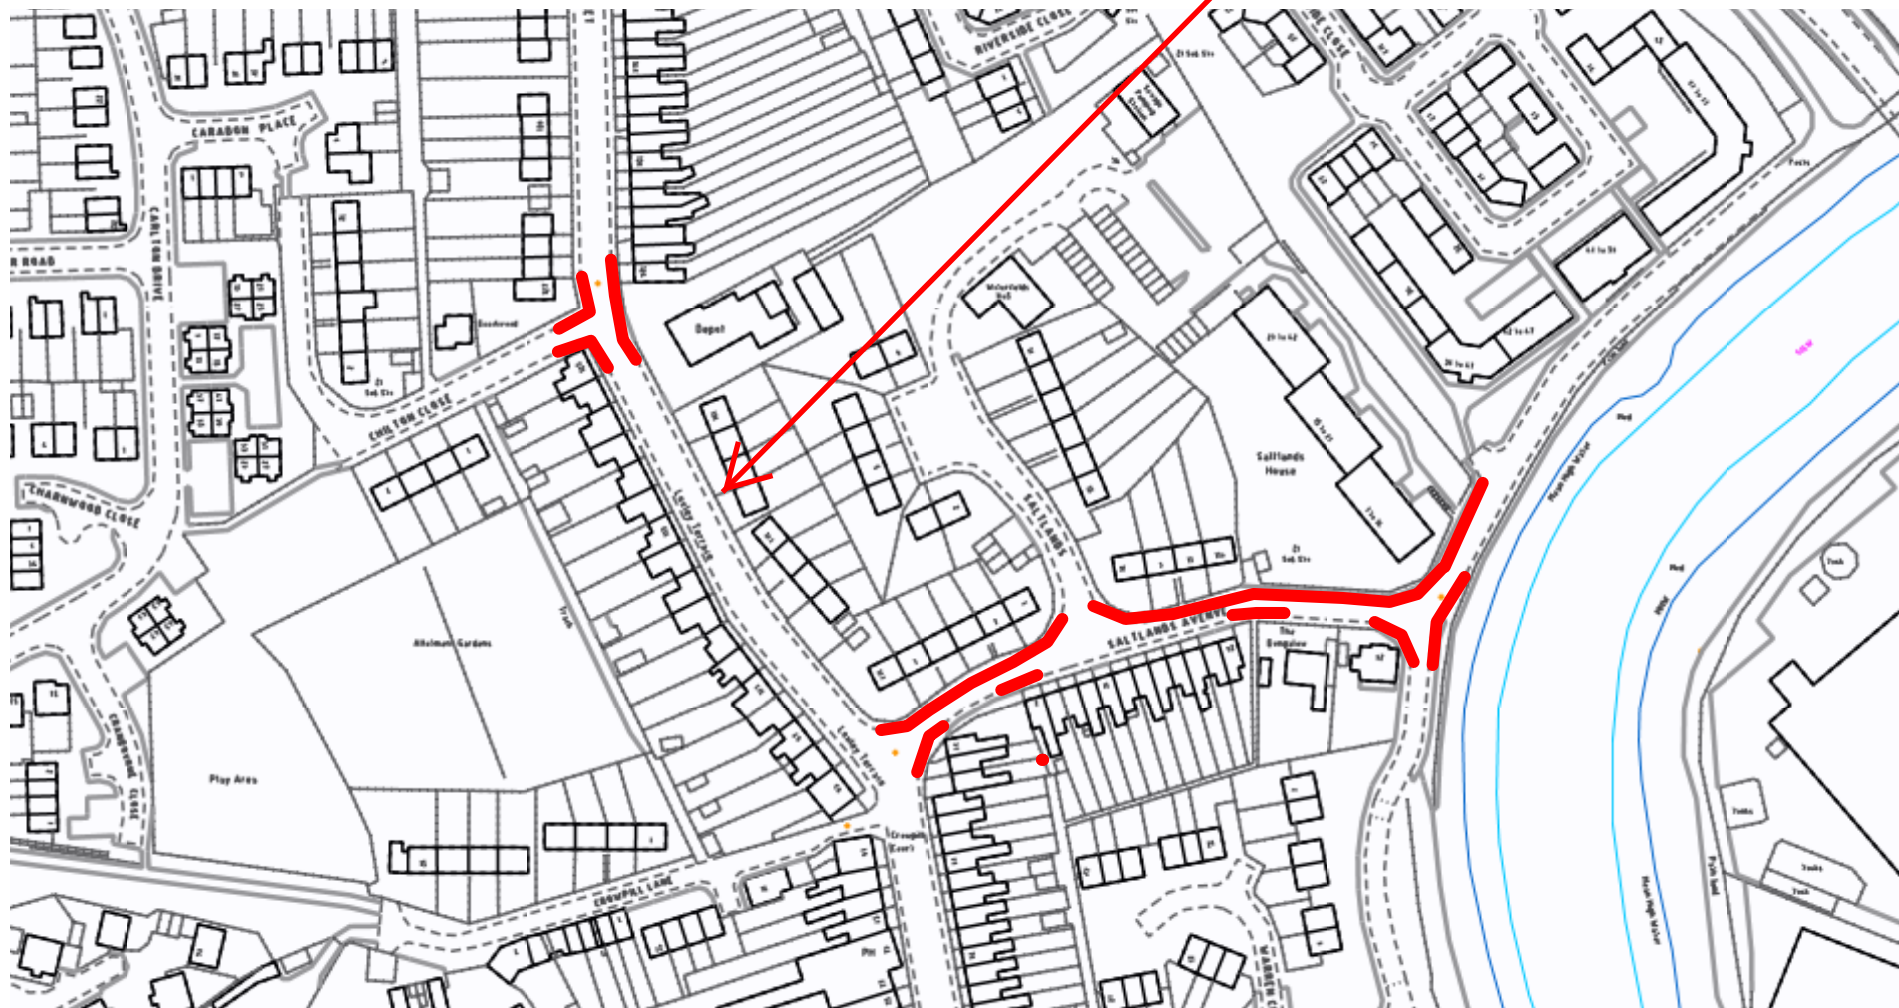

Somerset County Council 100038382 (2016) Crown Copyright



SOMERSET COUNTY COUNCIL
intranet MAPPING

CLARKS ROAD, BRIDGWATER - NWAAT

Scale - 1:892.813
Easting: 330991, Northing: 136799

Introduce No Waiting At
Any Time - Double Yellow
Lines as shown in red



Somerset County Council 100038382 (2017) Crown Copyright





SOMERSET COUNTY COUNCIL
intranet MAPPING

DANESBORO ROAD/ALFOXTON - NWAAT

Scale - 1:892.813

Easting: 328476, Northing: 136898



Introduce No Waiting At Any Time -
Double Yellow Lines as shown in
Red



Somerset County Council 100038382 (2017) Crown Copyright




SOMERSET COUNTY COUNCIL
intranet MAPPING

DURLEIGH ROAD/HAYGROVE ROAD - NWAAT (RED) AND SKC (BLUE)

Scale - 1:892.813

Easting: 328524, Northing: 136438

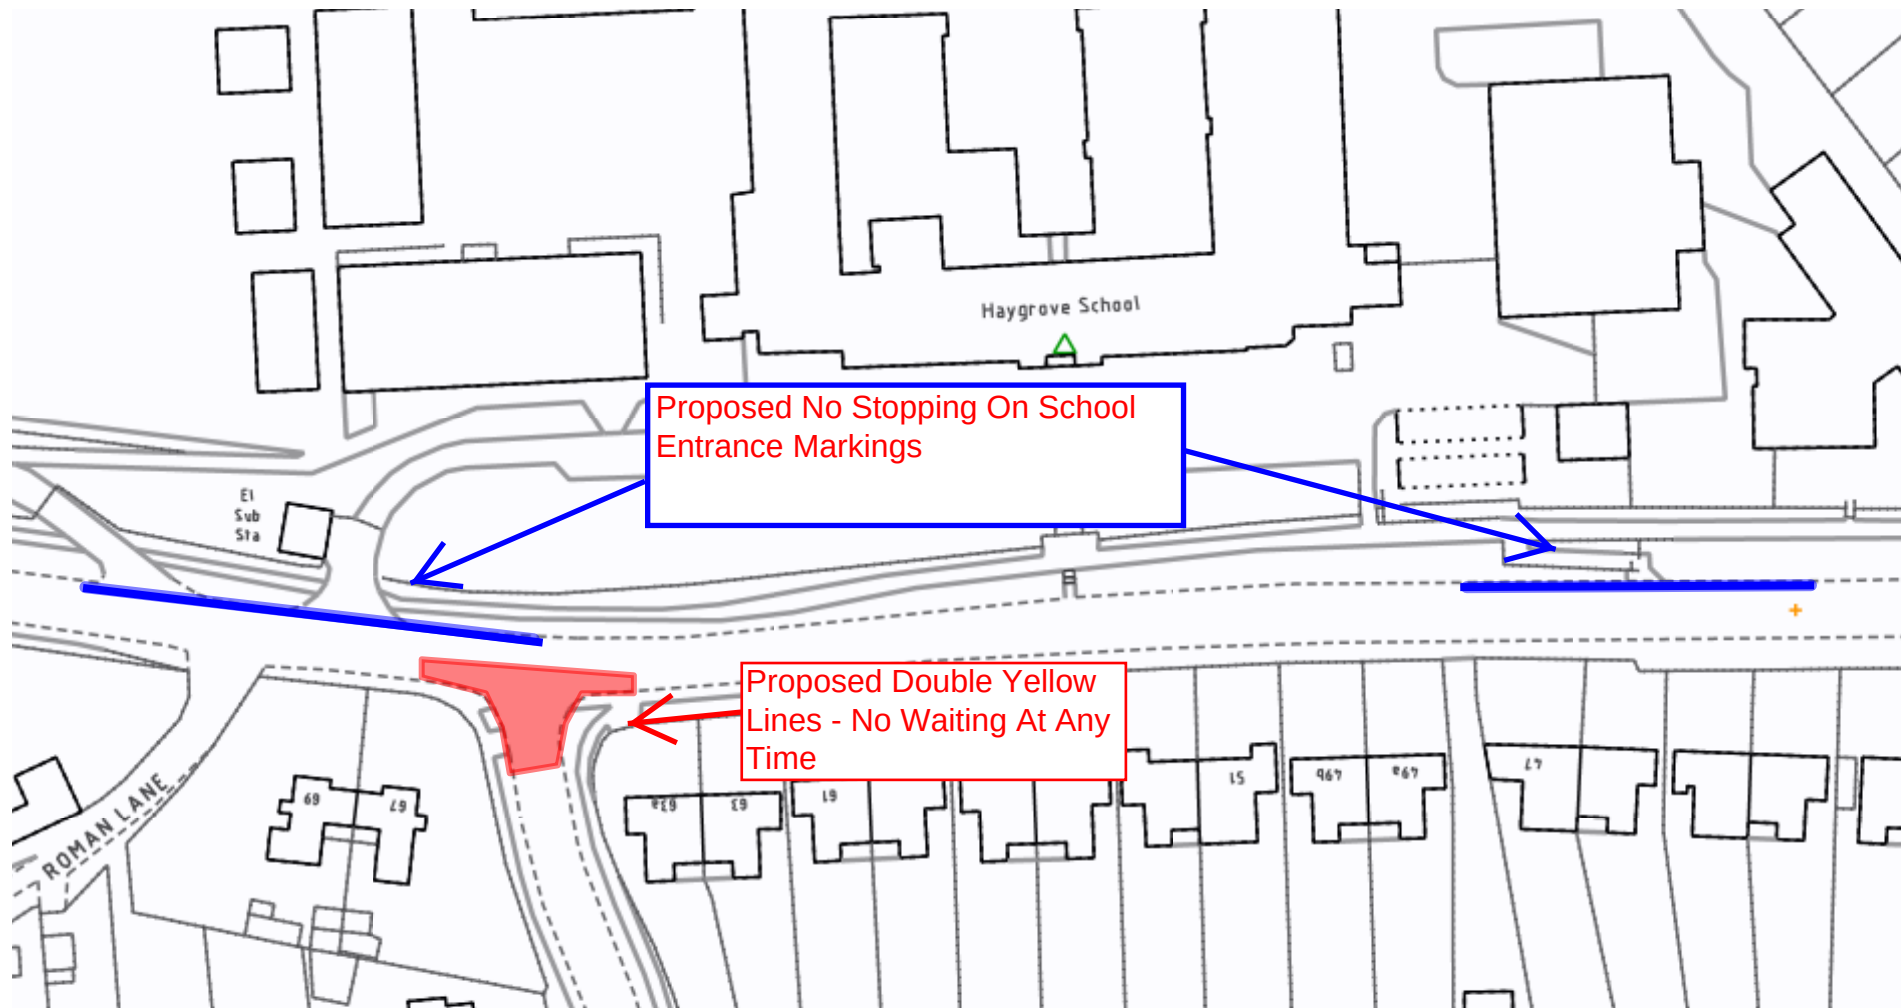

Proposed No Stopping On School
Entrance Markings

Proposed Double Yellow
Lines - No Waiting At Any
Time

Somerset County Council 100038382 (2016) Crown Copyright



SOMERSET COUNTY COUNCIL
intranet MAPPING

PARK ROAD/DURLEIGH ROAD - NWAAT

Scale - 1:892.813
Easting: 328989, Northing: 136541

Introduce No Waiting At Any
Time - Double Yellow Lines as
shown in red



Somerset County Council 100038382 (2016) Crown Copyright




SOMERSET COUNTY COUNCIL
intranet MAPPING

U7144/11 - Friarn Street, Bridgwater -
Revoke aprox 10 metres of No Waiting Mon-
Sat 8am-6pm

Easting: 329790, Northing: 136847

Change to Limited Waiting Mon-
Sat 8am-6pm 30 mins No Return
within 30 mins as shown in red

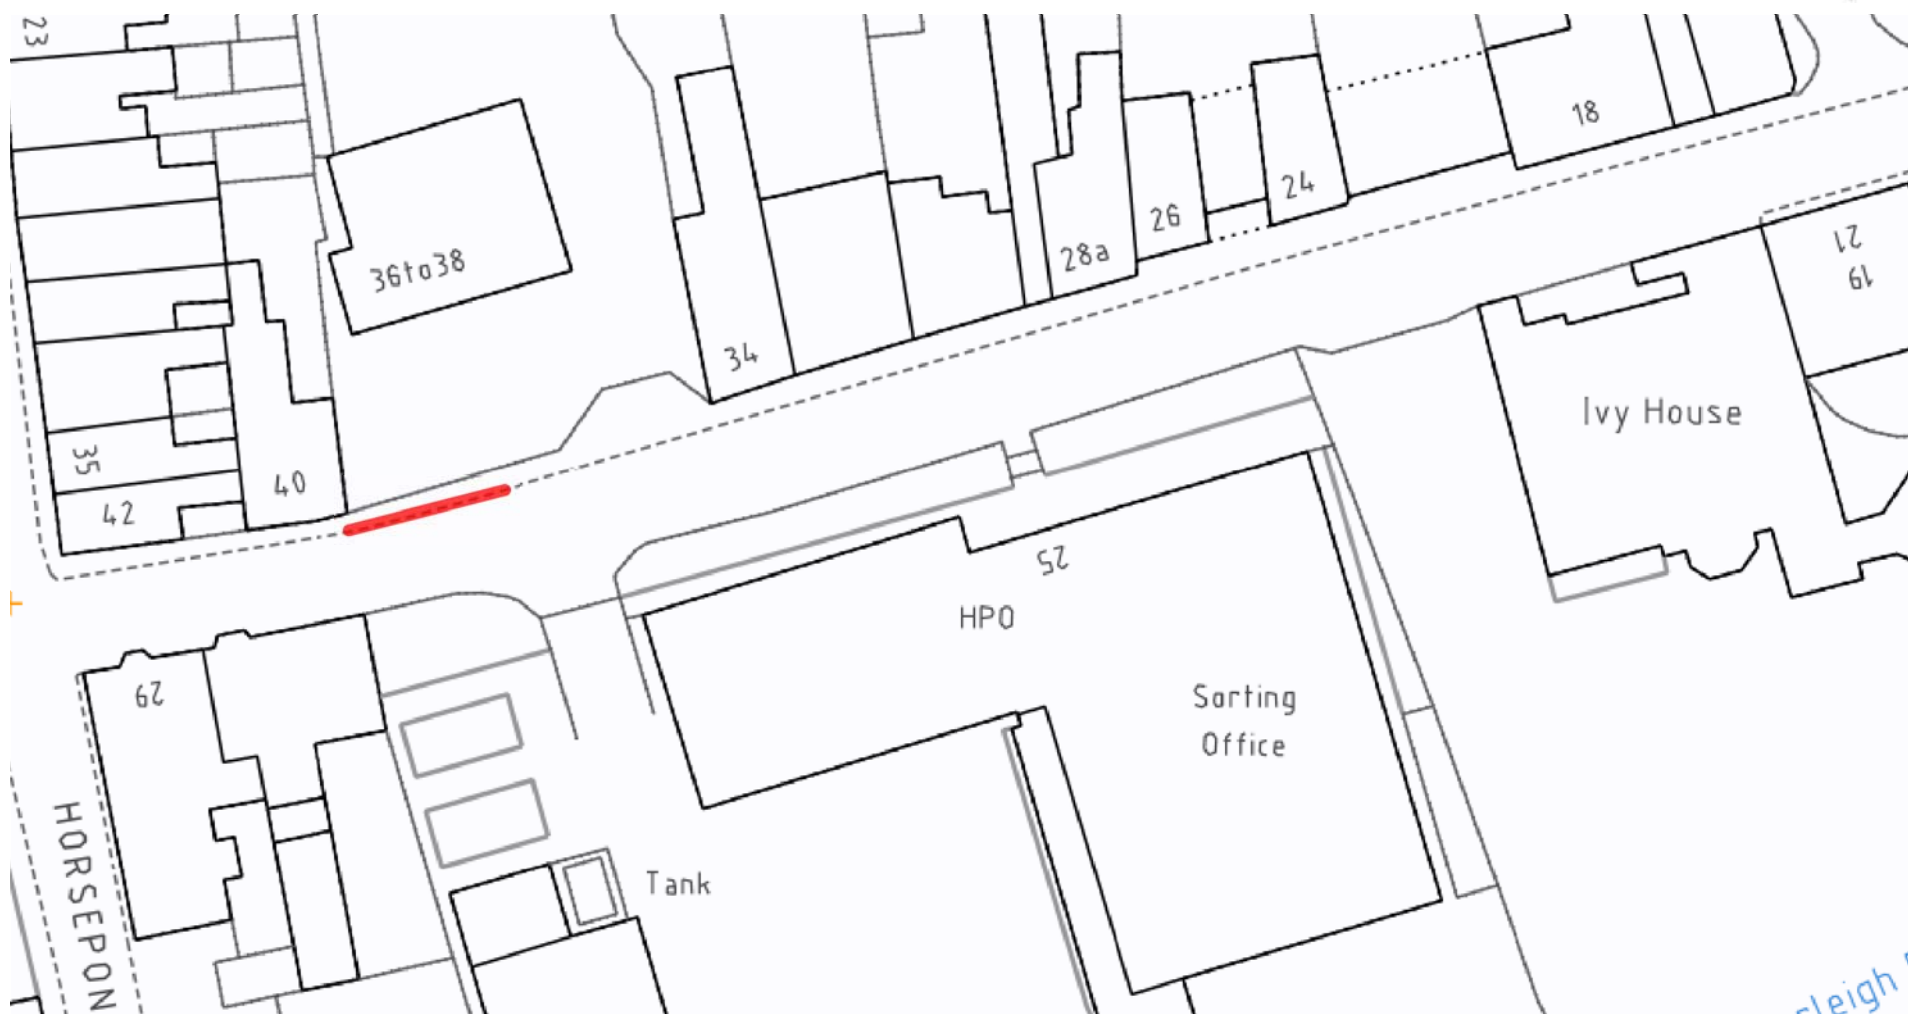

Somerset County Council 100038382 (2017) Crown Copyright



SOMERSET COUNTY COUNCIL
intranet MAPPING

GRASMERE/THE LAURELS, WEMBDON - NWAAT

Scale - 1:892.813

Easting: 328442, Northing: 137497

Introduce No Waiting At Any
Time - Double Yellow Lines as
shown in red



Somerset County Council 100038382 (2016) Crown Copyright



SOMERSET COUNTY COUNCIL
intranet MAPPING

KIDSBURY ROAD/CHURCH PATH,
BRIDGWATER - NWAAT

Scale - 1:892.813

Easting: 329098, Northing: 137411

Introduce No Waiting At Any
Time - Double Yellow Lines as
shown in red



Somerset County Council 100038382 (2017) Crown Copyright



Scale - 1:1,785.626
Easting: 329091, Northing: 136750

Introduce No Waiting At Any Time - Double Yellow Lines as shown in red



Somerset County Council 100038382 (2017) Crown Copyright



SOMERSET COUNTY COUNCIL
intranet MAPPING

OAKFIELD ROAD, BRIDGWATER - AMEND SYL TO MON-FRI 8-9:30AM/2:30-5PM

Scale - 1:892.813

Easting: 328294, Northing: 136651



Somerset County Council 100038382 (2017) Crown Copyright



SOMERSET COUNTY COUNCIL
intranet MAPPING

PENZOY AVENUE, BRIDWATER - MOVE DYL
TO OTHER SIDE AS SHOWN Scale -

1:892,813

Easting: 330932, Northing: 136648

Introduce No Waiting At Any
Time - Double Yellow Lines as
shown in red



Somerset County Council 100038382 (2016) Crown Copyright



SOMERSET COUNTY COUNCIL
intranet MAPPING

QUEENSWOOD ROAD/DURLEIGH ROAD,
BRIDGWATER - NWAAT

Scale - 1:1,785.626

Easting: 328026, Northing: 136493

Introduce No Waiting At Any
Time - Double Yellow Lines as
shown in red



Somerset County Council 100038382 (2016) Crown Copyright




SOMERSET COUNTY COUNCIL
intranet MAPPING

RHODE LANE, BRIDGWATER - NWAAT (RED) AND SKC (BLUE)

Scale - 1:1,785.626

Easting: 329692, Northing: 135893

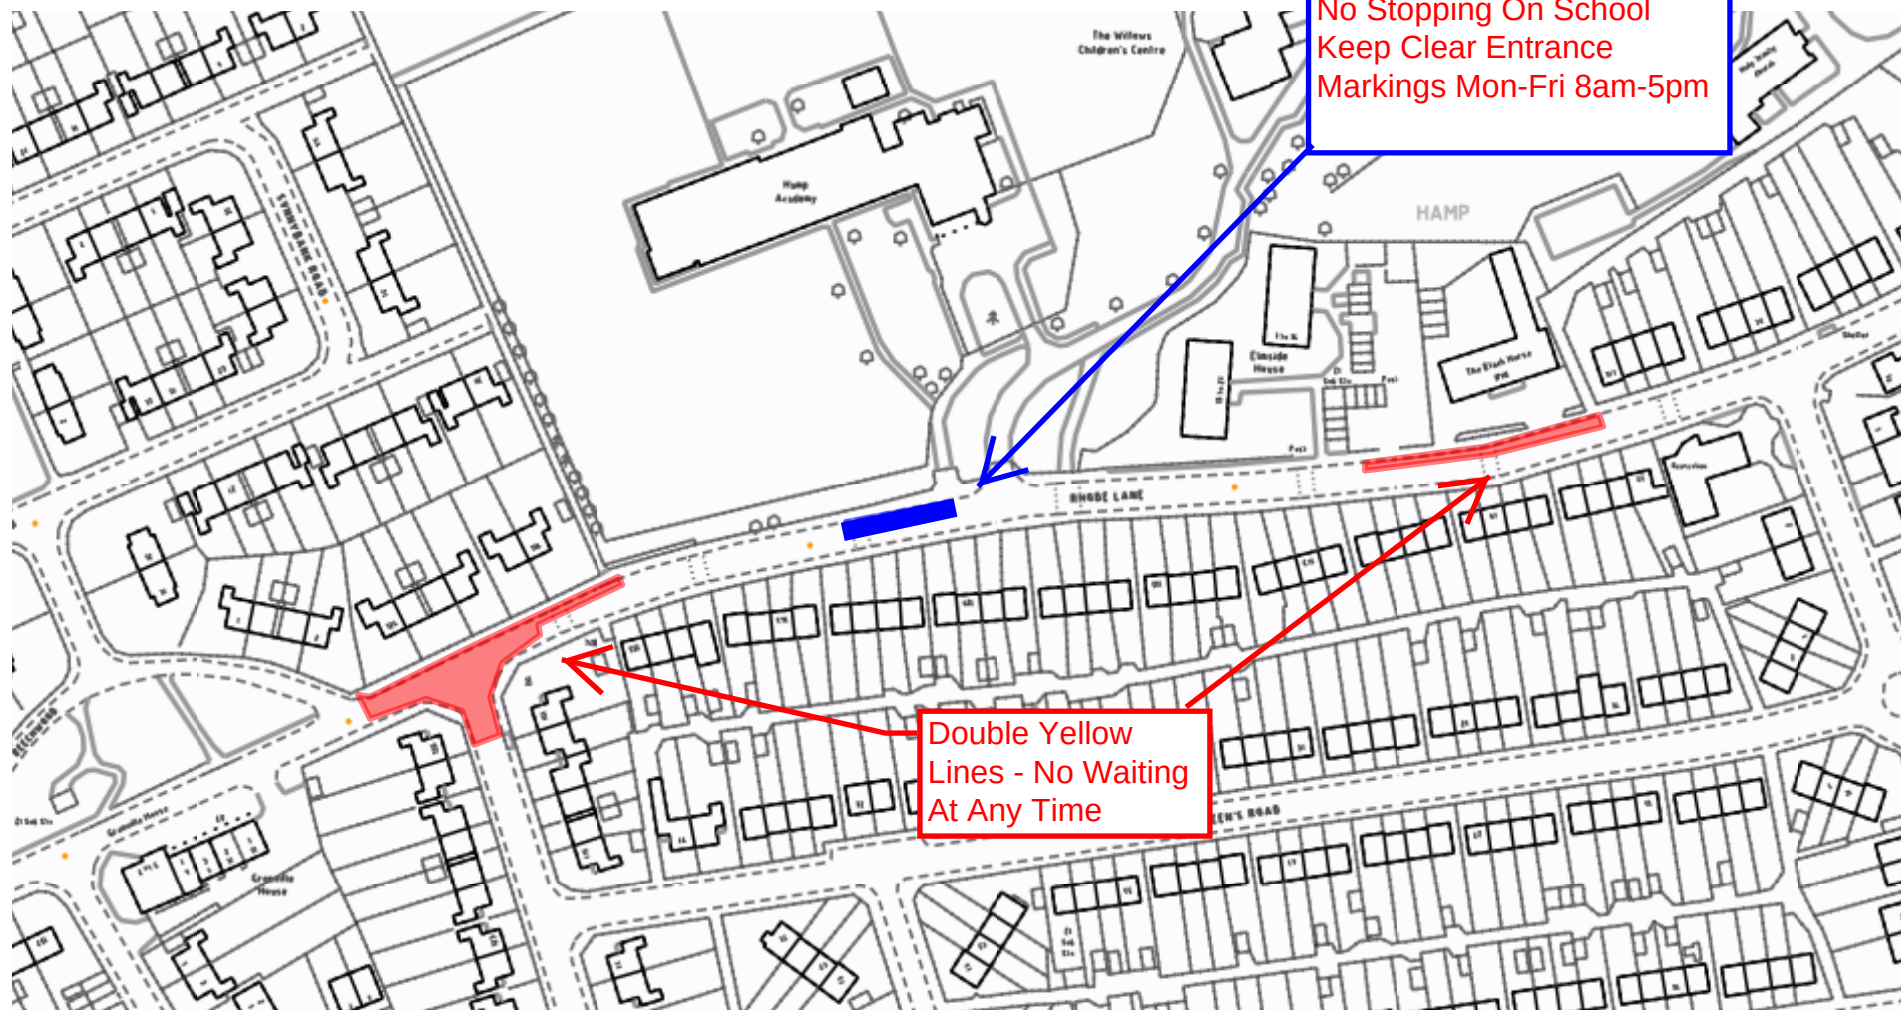

Somerset County Council 100038382 (2017) Crown Copyright



SOMERSET COUNTY COUNCIL
intranet MAPPING

Rosebery Avenue, Bridgwater - Proposed
extension to Double Yellow Lines as shown

Scale: 1:446,407

Easting: 330568, Northing: 137411



Somerset County Council 100038382 (2017) Crown Copyright



SOMERSET COUNTY COUNCIL
intranet MAPPING

ROBINS DRIVE/SYMONS WAY,
BRIDGWATER - NWAAT

Scale - 1:892.813

Easting: 330212, Northing: 137800

Introduce No Waiting At Any
Time - Double Yellow Lines as
shown in red



Somerset County Council 100038382 (2017) Crown Copyright




SOMERSET COUNTY COUNCIL
intranet MAPPING

WELLINGTON ROAD, BRIDGWATER - INTRODUCE MON - FRI 8AM -6PM

Scale - 1:892.813

Easting: 330709, Northing: 137000

Introduce No Waiting Mon-Fri
8am-6pm Single Yellow Line as
shown in red

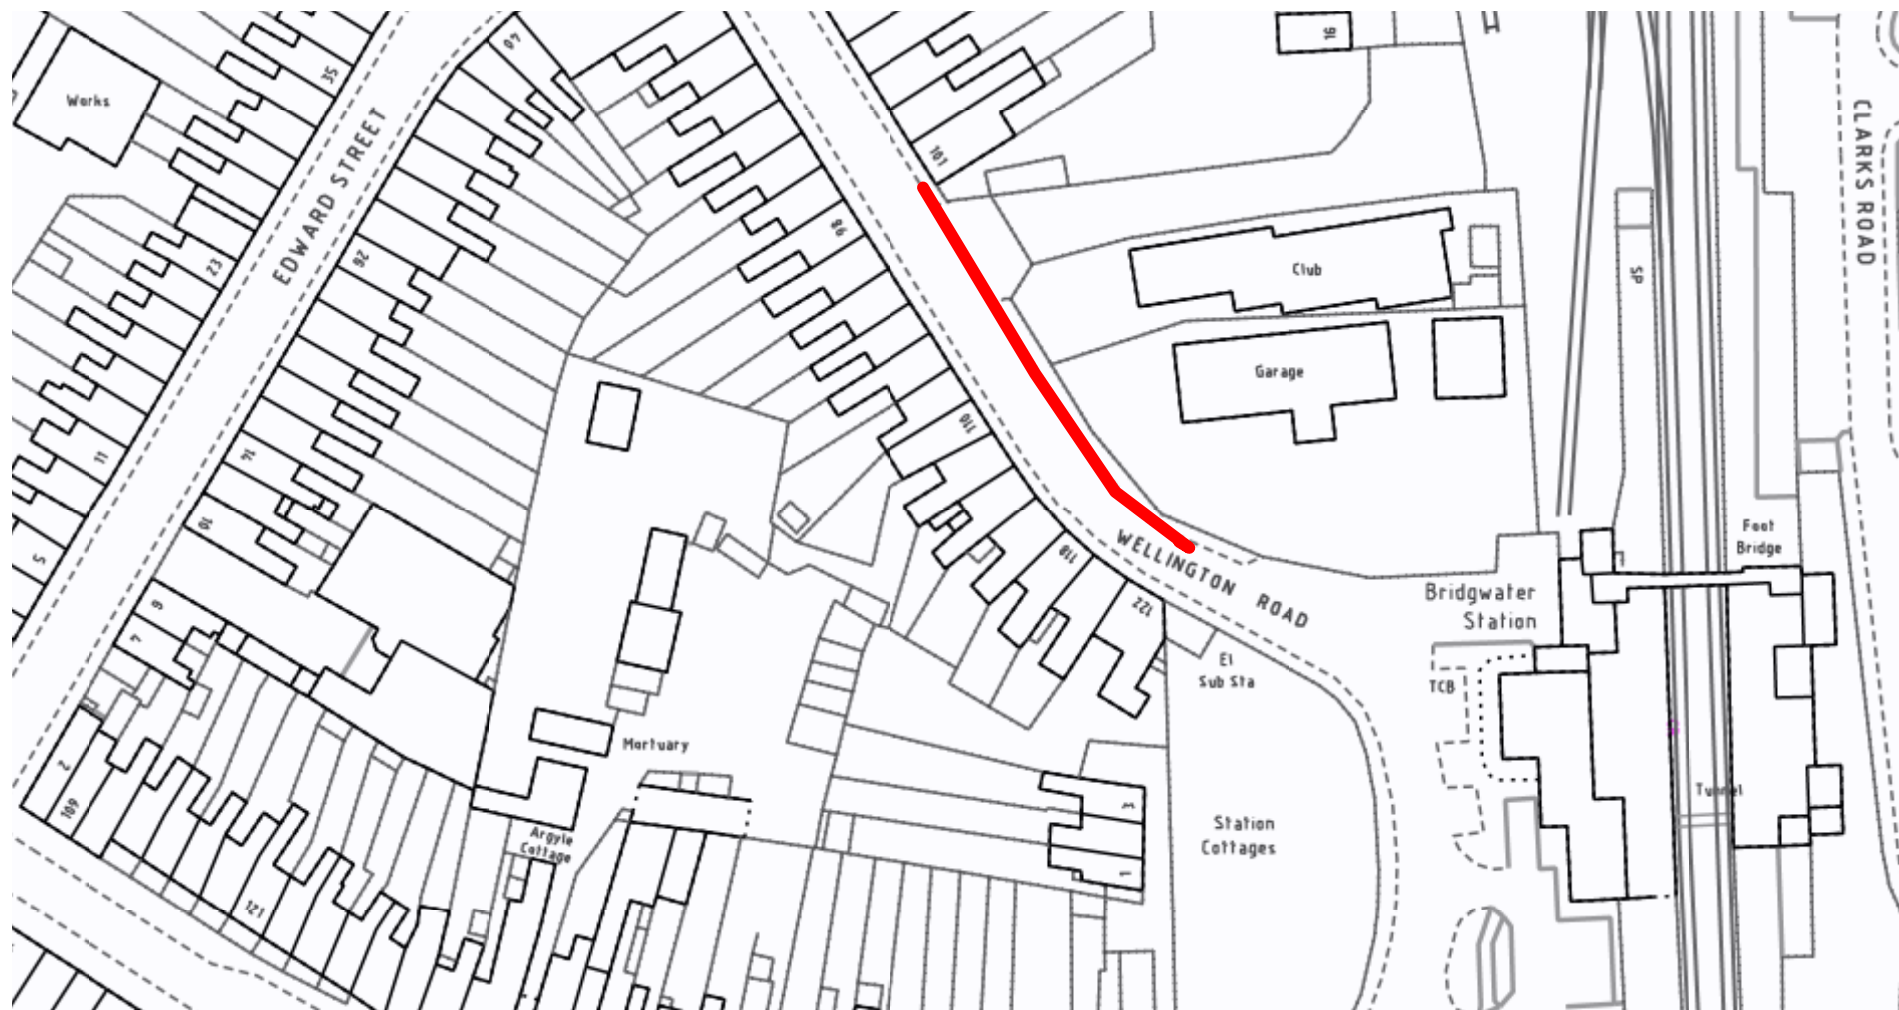

Somerset County Council 100038382 (2016) Crown Copyright



SOMERSET COUNTY COUNCIL
intranet MAPPING

WEMBDON RISE - RED = EXTEND
EXISTING RESTRICTION / BLUE = REVOKE

Scale - 1:892.813

Easting: 328653, Northing: 137295



Somerset County Council 100038382 (2017) Crown Copyright