

1. APPLICATION FORM FOR A MODIFICATION TO THE DEFINITIVE MAP AND STATEMENT

We (Name) SHEKTON MANOR TOWN COUNCIL
of

(Address) 1 PARK ROAD, SHEKTON MANOR, SOMERSET
Postcode BA4 5BS

hereby apply for an order under Section 53 (2) of the Wildlife and Countryside Act 1981
modifying the Definitive Map and Statement for the area by:-

(Please select as appropriate.)

(a) ~~Deleting the footpath / bridleway / restricted byway / byway open to all traffic which runs from:~~

~~to:~~

(b) ~~Adding the footpath / bridleway / restricted byway / byway open to all traffic which runs from:~~

~~MIDDLETON LANE TO THE SOUTH, BETWEEN NUMBER 4 & 5 MIDDLETON LANE, BA4 5QY.~~

~~to:~~
~~WATERLOO WAY IN THE SOUTH - AN WITHIN SHEKTON MANOR~~

(c) ~~Up-grading / down-grading to a footpath / bridleway / restricted byway / byway open to all traffic the footpath / bridleway / restricted byway / byway open to all traffic which runs from:~~

~~to:~~

(d) ~~Varying / adding to the particulars relating to the footpath / bridleway / restricted byway / byway open to all traffic which runs from~~

to:

by providing that: an important SUBURBANS OF WAY
LINK BETWEEN THE PUBLIC AREAS and shown on the signed map annexed hereto.

2. SERVICE OF NOTICE OF APPLICATION FOR A MODIFICATION ORDER

It is a requirement of paragraph 2 of Schedule 14 to the Wildlife and Countryside Act 1981 that an applicant for a Modification Order shall serve a Notice stating that the application has been made, on every owner and occupier of any land to which the application relates.

The form of Notice, defined by the regulations, is set out in the Council's "notice of application" form, which should be addressed and sent to every owner and occupier of land over which the alleged way runs. Please find this enclosed with this application pack. Please copy this form as many times as required.

It is the duty of the applicant to investigate the ownership and occupation of the land so that the necessary Notice may be served.

2a. Please confirm that you have carried out an investigation in an attempt to discover the owners and occupiers of the land over which the alleged way runs by signing the below declaration.

I have made enquiries from (please delete those that are not applicable)

- Adjoining landowners
- Local inhabitants
- ~~Post office~~
- Parish Council
- Register of B

Signed

Date

27 APR 2012

2b. Should you not be able to identify the owners and occupiers of the land over which the alleged way runs please contact the Land Registry for details as to how to make a search.

Please attach any search results with this application pack.

For applications in Sedgemoor, Mendip, Taunton Deane, and West Somerset please contact the Plymouth office:

Land Registry, Plymouth Office
Plumer House
Tallyour Road
Crownhill
Plymouth PL6 5HY

TEL: 01752 636000
FAX: 01752 636161

• All Wheel Drive Club
✓ Mr S Addicott
County Liaison Officer
35 Burcott Road
Wells
BA5 2EF

• English Heritage
✓ Mr N Russell
Field Monument Warden
29 Queen's Square
Bristol
BS1 4ND

• English Nature
✓ Dr A King
Area Team Manager
Natural England
Riverside Chambers
Castle Street
Taunton
TA1 4AP

• Open Spaces Society
✓ 25A Bell Street
Henley-on-Thames
Oxon RG9 2BA

• Police Architectural Liaison Officer
✓ Police Station
Shuttern
Taunton
Somerset

• The Rambler's Association
✓ 2nd Floor
Camelford House
87-90 Albert Embankment
LONDON
SE1 7TW

Please attach a list showing who you have consulted and copies of any replies to your enquiries to this application form.

7. SIGNATURE OF THE APPLICANT

Please sign and date the form below.

Signature of applicant

SIGNED

DATED

Witness signature

Dated

Witness name and address in block capitals

CHAIRMAN OF THE TOWN COUNCIL
27 WATERLOO ROAD, SHUTTERN MAVER, SOMERSET
BA4 5HH

A signed map with the claimed route marked clearly must be attached to this form.

Shepton Mallet CP

GMIS Web Mapping PDF

Date: 5-3-2012

Scale: 1:737


Map Centre

361804

142665

ParishOnline

© Crown copyright and database right. All rights reserved (100030836) 2012

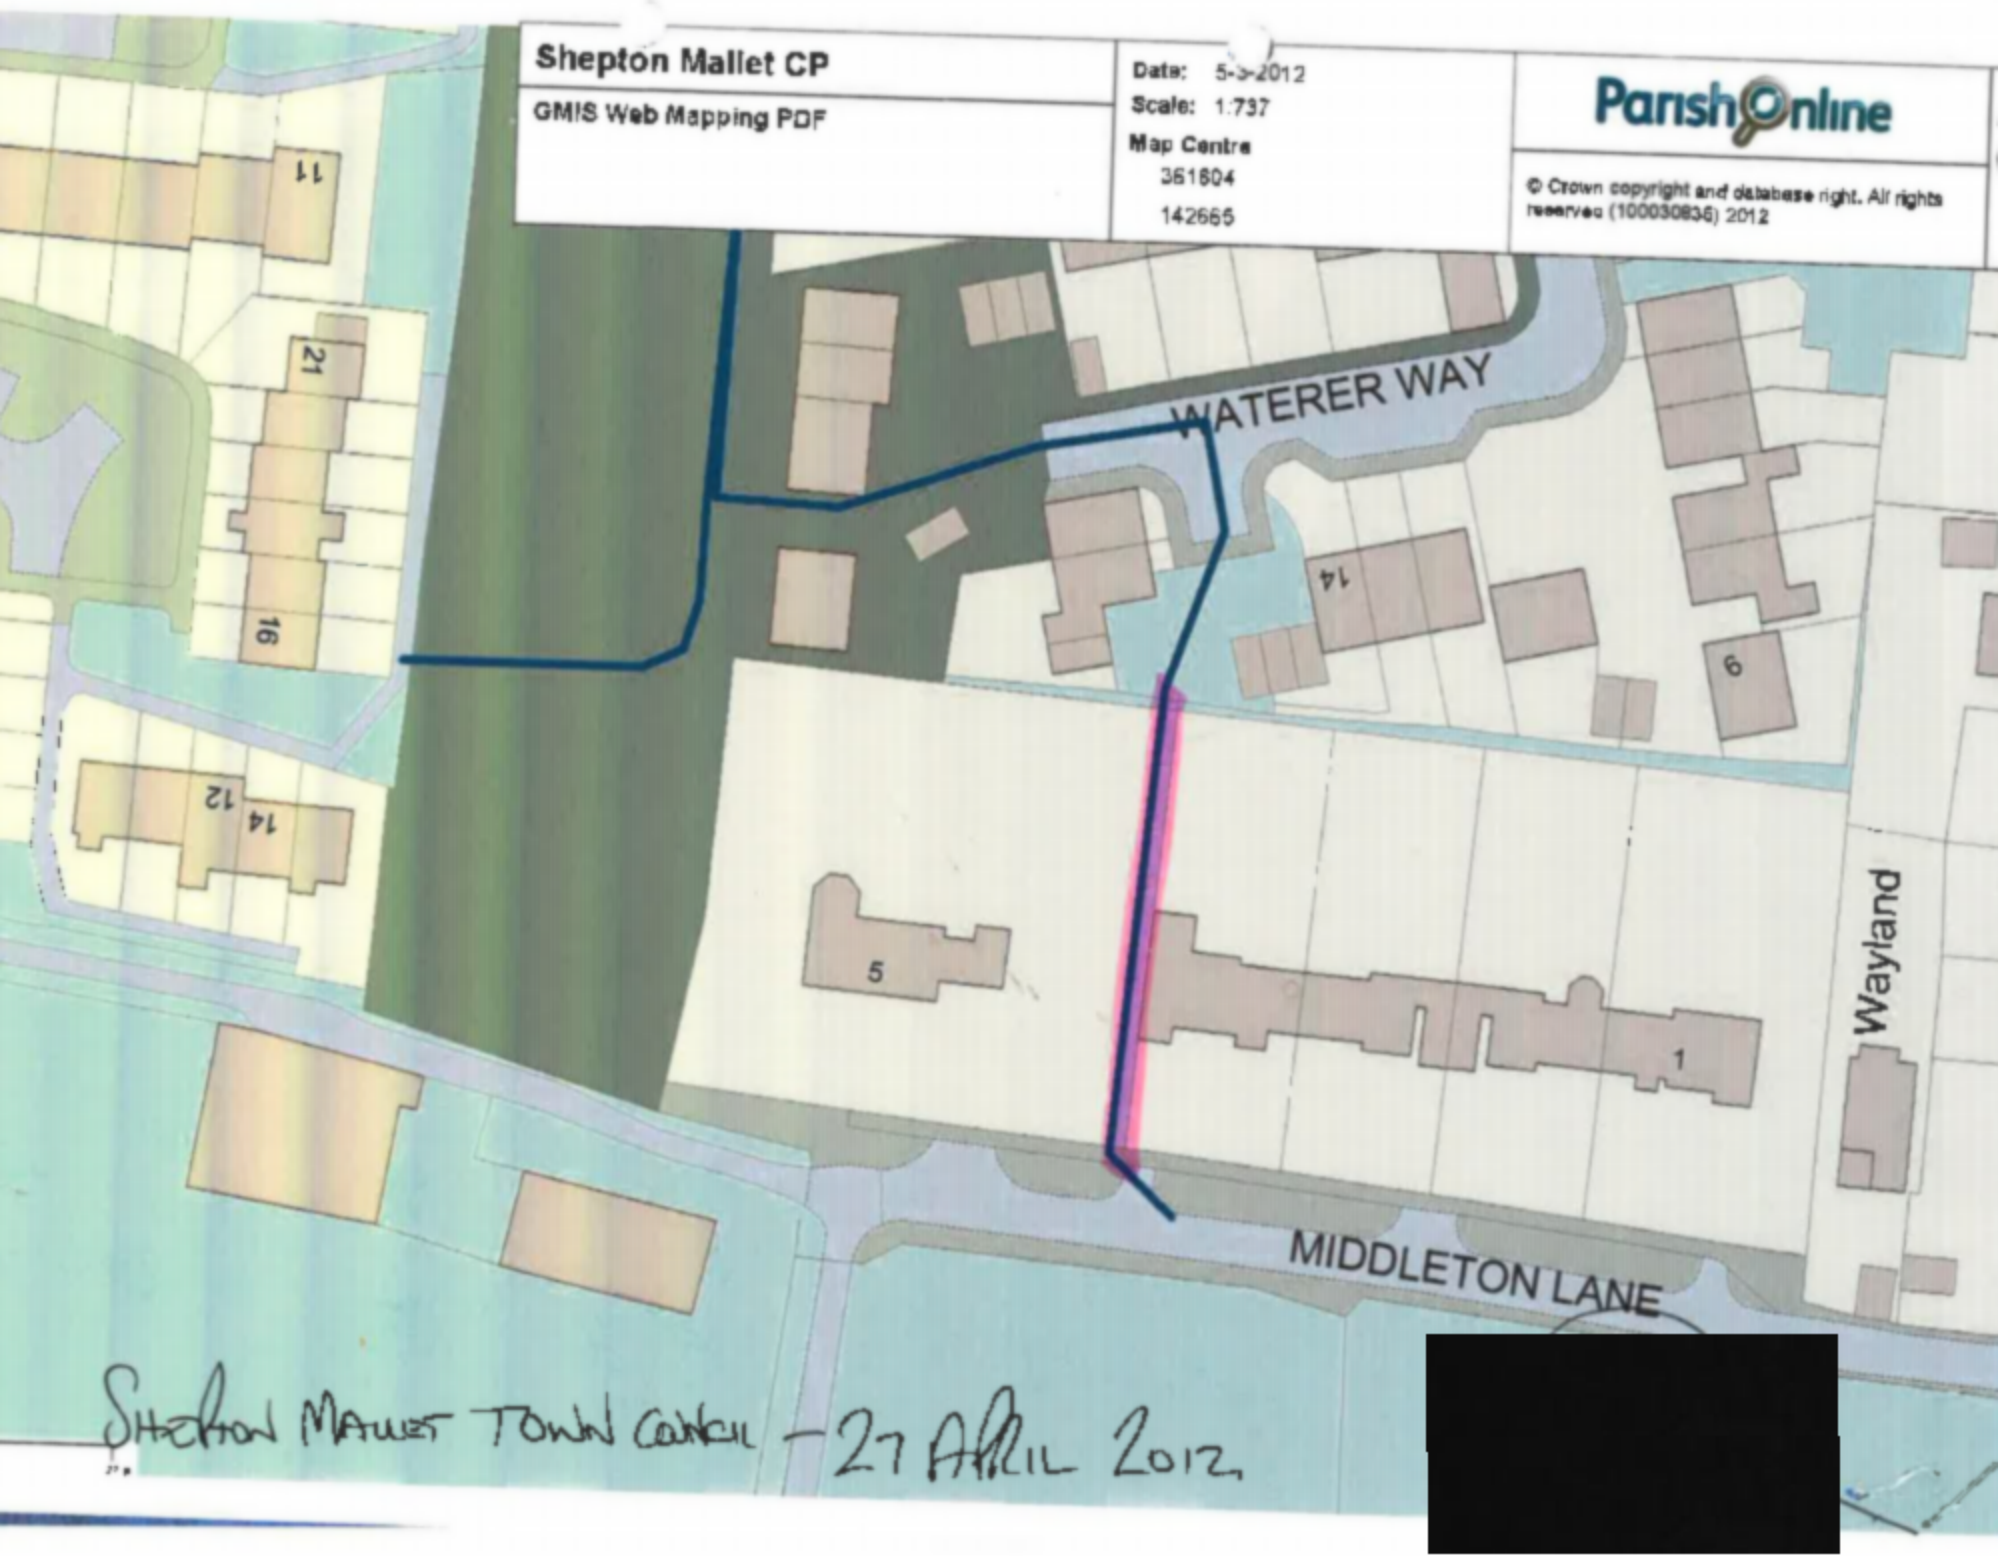

Shepton Mallet Town Council - 27 April 2012