

SOMERSET COUNTY COUNCIL

WILDLIFE & COUNTRYSIDE ACT 1981

NOTICE OF APPLICATION FOR MODIFICATION ORDER

NOTES FOR GUIDANCE OVERLEAF - PLEASE READ CAREFULLY

Section A

To: Owners and occupiers
 of: land along Westport Canal (see plan)

Section B Notice is hereby given that on.....

28th November 2005

I / ~~We~~ The Corporate Director
 of: the Environment Department

have made an application to the Somerset County Council that the Definitive Map and Statement for the area be modified by: -

Section C

- (i) ~~Deleting the footpath / bridleway / byway open to all traffic *~~ part of footpath L 9/24 which runs
 from: the junction with L 9/22 along the Western bank of the Westport Canal
 to: Middle Moor Bridge at the junction with footpaths L 9/21 and L 10/18
- (b) ~~Adding the footpath / bridleway / byway open to all traffic *~~ the junction with L 9/22 along the eastern bank of the Westport Canal which runs
 from: the junction with L 9/22 along the eastern bank of the Westport Canal
 to: Middle Moor Bridge at the junction with footpath L 10/18
- (c) ~~Up-grading / down-grading to a footpath / bridleway / byway open to all traffic * the footpath / bridleway / byway open to all traffic *~~ which runs
 from:
 to:
- (d) ~~Varying / adding to the particulars relating to the footpath / bridleway / byway open to all traffic *~~ which runs
 from:
 to:
 by providing that:

Signed:

Dated: 12th April 2006

* Please delete as appropriate

for further information please contact Tabitha Sutton on
 01823 356928 or TSutton@Somerset.gov.uk

SOMERSET COUNTY COUNCIL

WILDLIFE & COUNTRYSIDE ACT 1981

NOTICE OF APPLICATION FOR MODIFICATION ORDER

NOTES FOR GUIDANCE OVERLEAF - PLEASE READ CAREFULLY

Section A To: Mr. Bisgrave
of: Newton Farm, Newton

Section B Notice is hereby given that on 28th November 2005

I / The Corporate Director
of: the Environment Department

have made an application to the Somerset County Council that the Definitive Map and Statement for the area be modified by: -


Section C

- (i) ~~Deleting the footpath /~~ part of footpath L 9/24 ~~bridleway / byway open to all traffic~~ * which runs
from: the junction with L 9/22 along the western bank of the
Westport Canal
to: Middle Moor Bridge at the junction with footpaths L 9/21 and
L 10/18
- (b) ~~Adding the footpath /~~ from: the junction with L 9/22 along the eastern bank of the
Westport Canal
to: Middle Moor Bridge at the junction with footpath L 10/18
- (c) ~~Up-grading / down-grading to a footpath / bridleway / byway open to all traffic * the footpath / bridleway /~~
~~byway open to all traffic * which runs~~
from:
to:
- (d) ~~Varying / adding to the particulars relating to the footpath / bridleway / byway open to all traffic * which runs~~
from:
to:
by providing that:

Signed:

Dated: 10th April 2006

* Please delete as appropriate

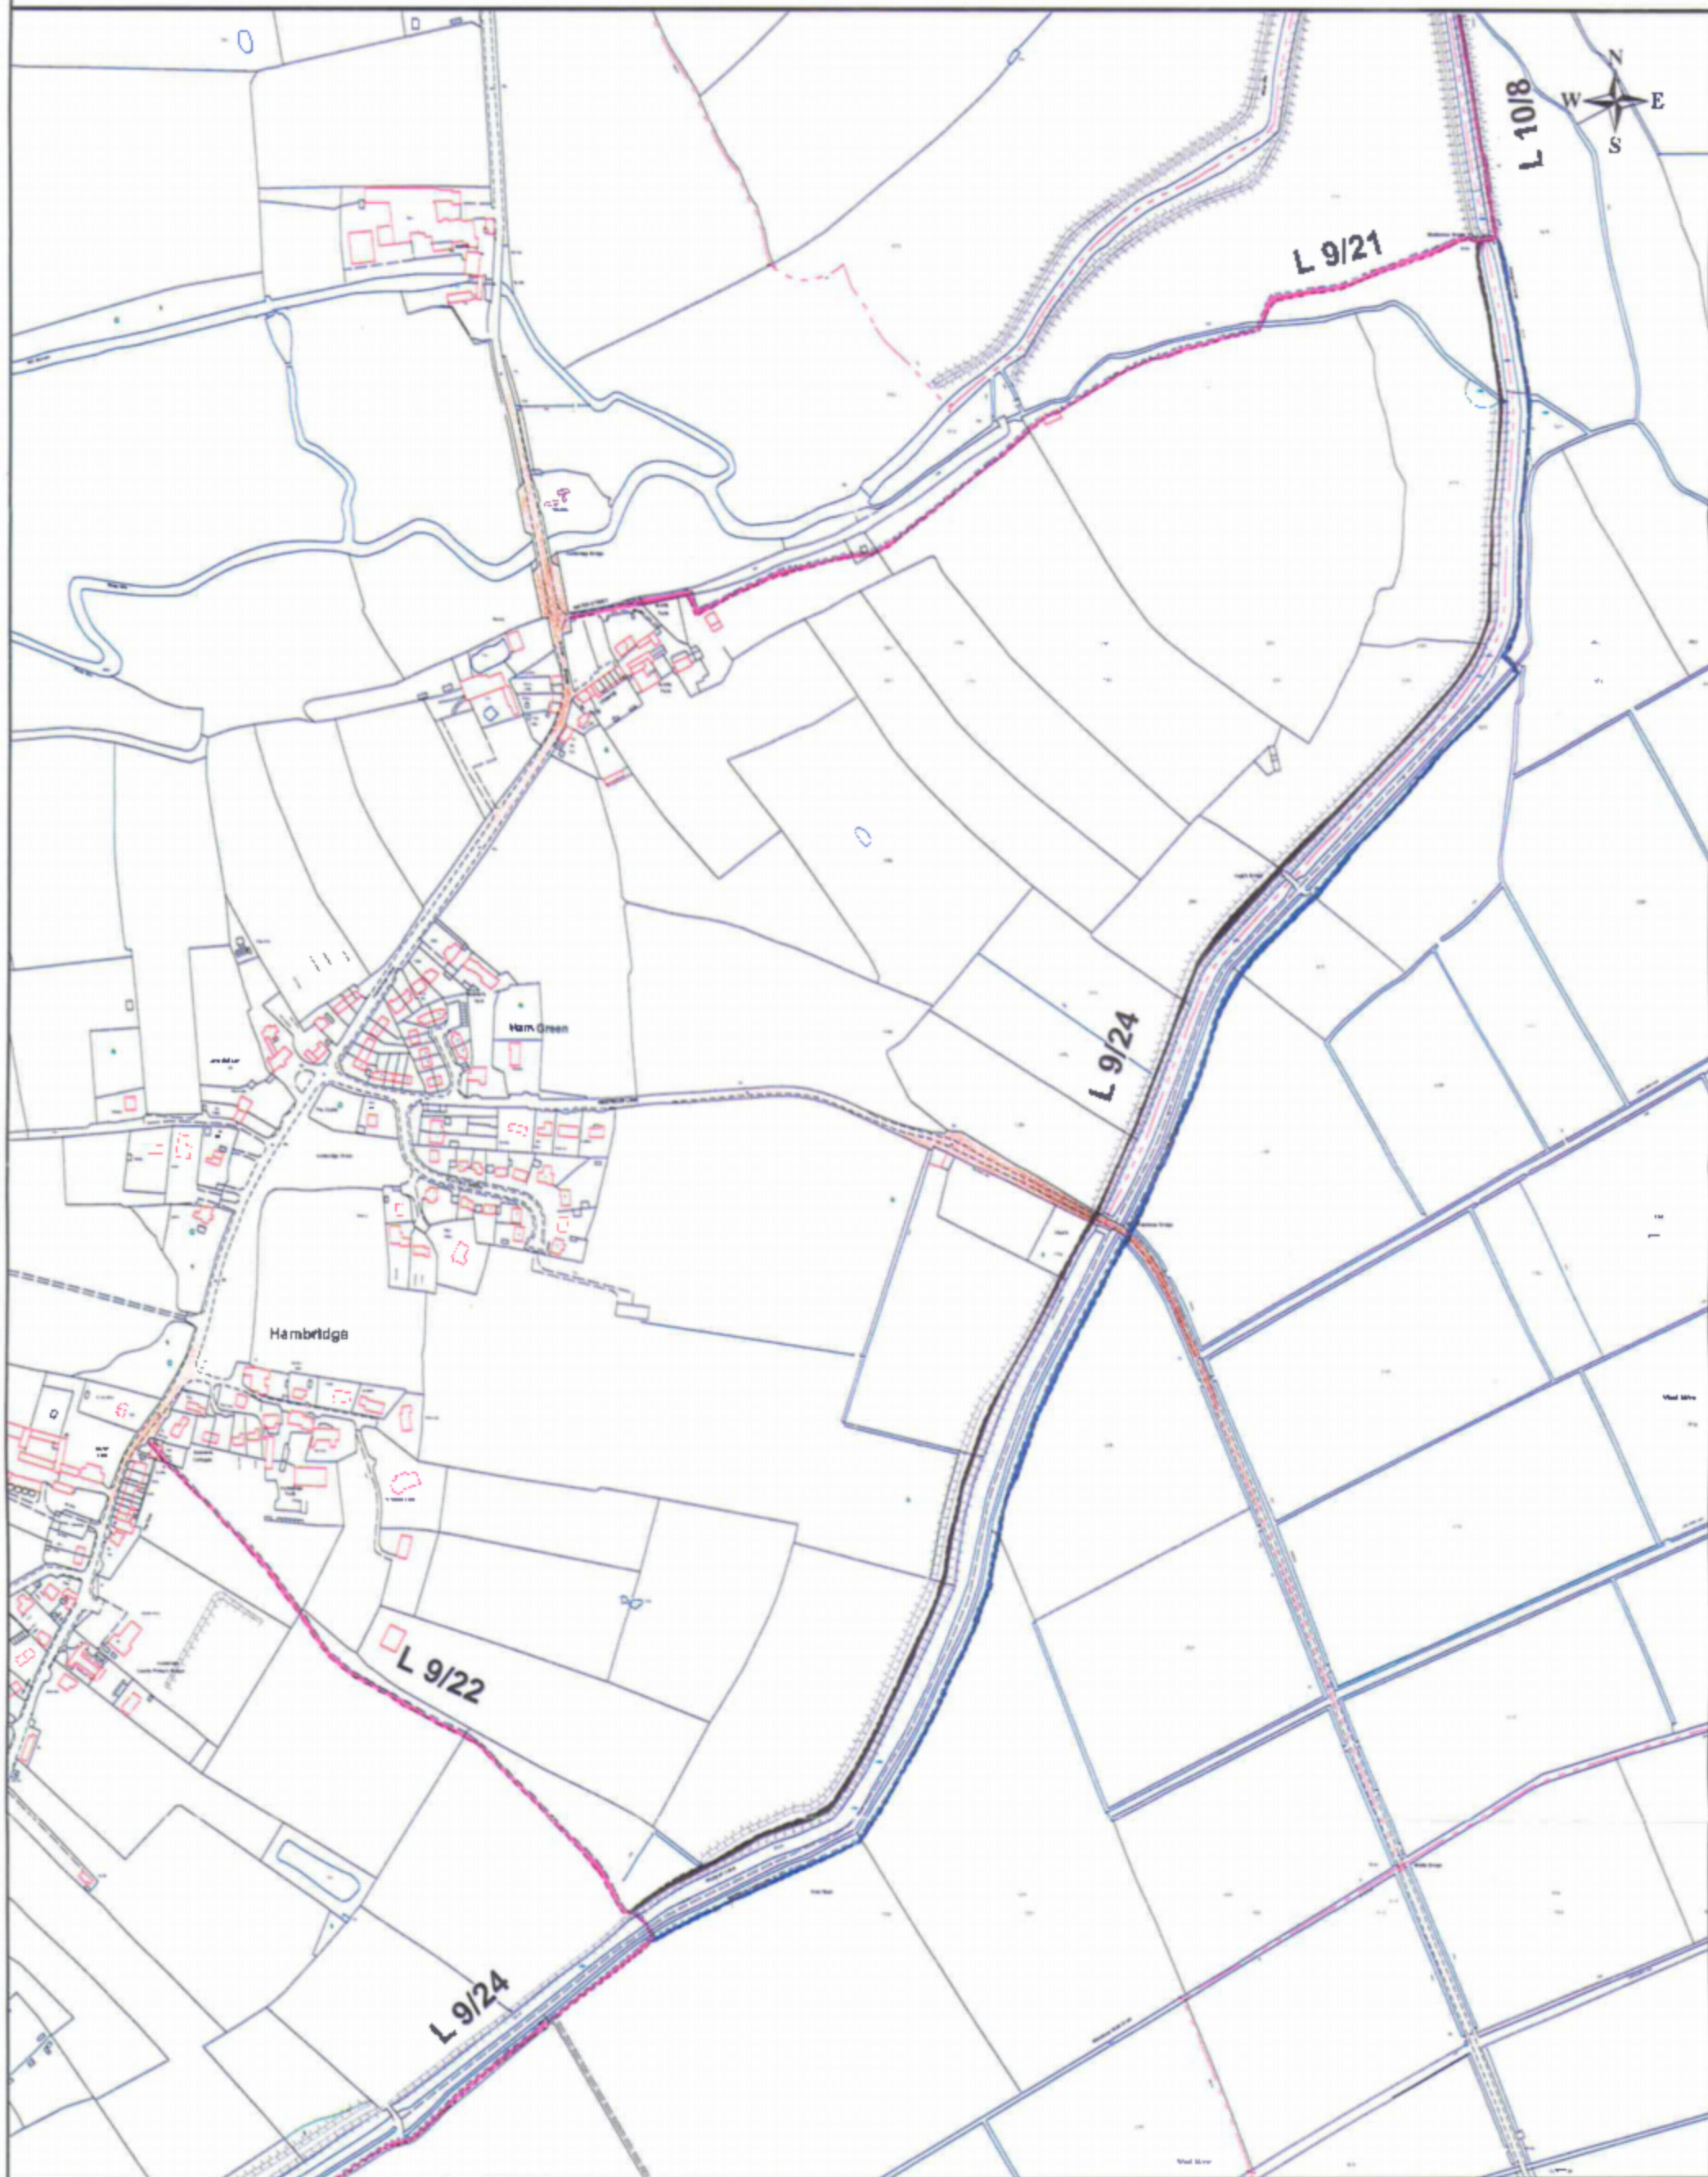

Parish: Hambridge and Westport
 District: South Somerset
 Date: 10/04/2006
 Drawing No: H123-2006
 Drawn By: MHardwill
 Centre Grid Ref: 340122 121461
 Scale: 1:5000

Definitive Footpath
 Proposed Route to be Deleted
 Proposed Route to be Added
 County Road



The precise line of a Right of Way can only be determined by reference to the Definitive Map (1:10000 scale) and the attached plan has been produced by transposing the Rights of Way Definitive Map onto a larger scale.

The Somerset County Council can accept no responsibility for any error or inaccuracy which may arise from the transposition of the Rights of Way Definitive Map to a different scale.