A39 WILLITON TO BRIDGWATER CLOSURE:
YELLOW / CYAN ROUTE DIVERSION:
FOR DETAILS OF FOLDING SIGN LOCATIONS SEE DRGS. TI004002-HW-SM-402 TO 406.
FOR DETAILS OF FOLDING SIGN REQUIREMENTS SEE DRGS. TI004002-HW-SM-410 TO 415.

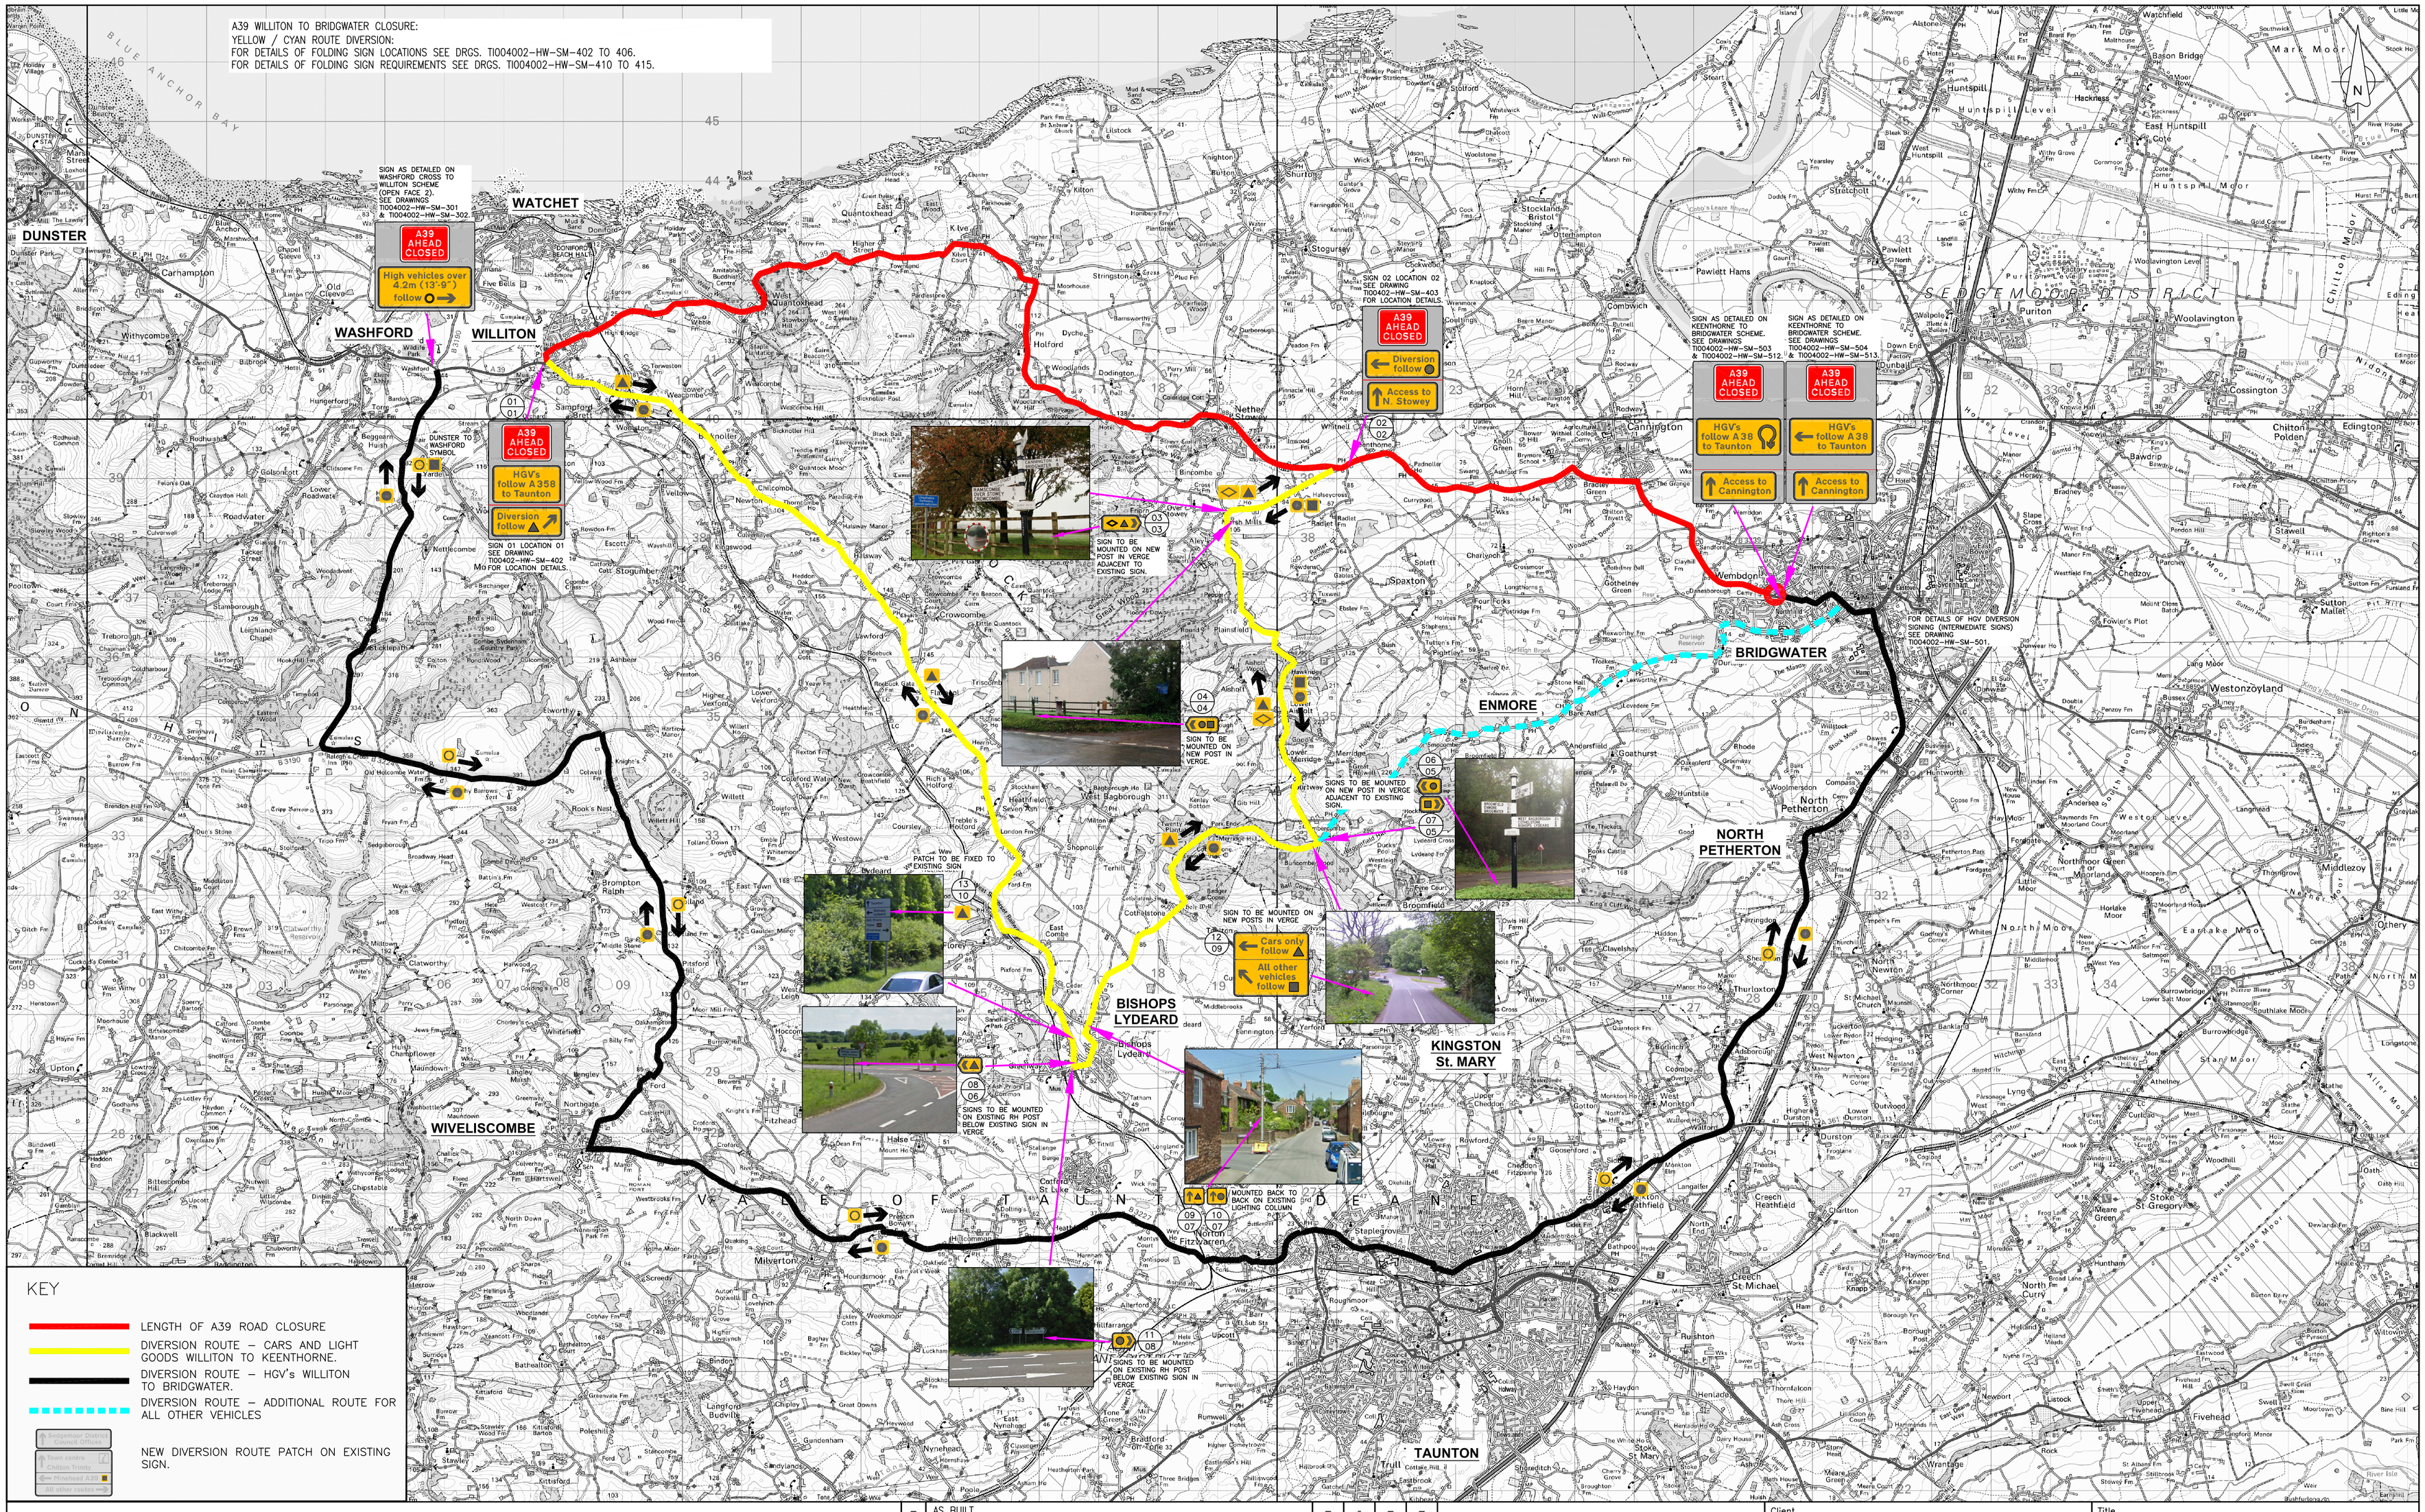

© Crown Copyright and database right (2012). Ordnance Survey 100038382

Rev	Description	By	Date	Chk'd	Auth
–	AS BUILT	–	–	–	–
–	–	–	–	–	–
–	–	–	–	–	–
–	–	–	–	–	–
–	–	–	–	–	–
–	–	–	–	–	–
–	–	–	–	–	–
–	–	–	–	–	–
–	–	–	–	–	–
–	–	–	–	–	–

Somerset County Council ©
Engineering Design Team
County Hall
Taunton
Somerset
TA1 4DY
TEL: (0845) 3459155
FAX: (01823) 358064
www.somerset.gov.uk

Client
SOMERSET COUNTY COUNCIL

Project
A39 DIVERSION ROUTES
YELLOW ROUTE

Title
WILLITON TO KEENTHORNE
SIGNS AND PATCH LOCATIONS

File Name: TI004002-HW-SM-1306_Rev-Emergency Route Sign Patch

Original Scale	Drawn	Checked	Authorised	Status
1:20000 @ A1	EL	LK	MJB	AB
	Date 18/04/2016	Date 18/04/16	Date 09/06/16	

Drawing Number
TI004002-HW-SM-401

Rev
-

Filepath: T:\ENGINEERING DESIGN TEAM\LTP Schemes\TI004002 – A39 Diversion Routes\General (items relating to whole scheme)\40 CAD\41 Working Drawings\Sign Patch-1300 Series Drwgs\Williton-Keenthorne-Bridgwater