

1. Application form for a Modification to the Definitive Map and Statement

What steps have you taken in respect of the route being claimed, up until now, prior to completing this form? Please provide details below. BRIDLEWAY DEDICATED

(EDCL) 2006, FUNDED & CONSTRUCTED 2006, IN USE TO PRESENT DAY

I/We (Name) RACHEL THOMPSON MBE

of (Address) TRAILS TRUST, TOWNSEND COTTAGE, TOWNS

PRIDOT, WELLS, SOMERSET Postcode BAS 3BP

hereby apply for an order under Section 53 (2) of the Wildlife and Countryside Act 1981 modifying the Definitive Map and Statement for the area by:-

(Please select one or more categories as appropriate)

☐ (a) **Deleting** the footpath / **bridleway** / restricted byway / byway open to all traffic which runs from:

to:

☒ (b) **Adding** the footpath / **bridleway** / restricted byway / byway open to all traffic which runs from: FR 18/18 LD ON ATTACHED MAP

to: FR 18/17 (E ON ATTACHED MAP)

☒ (c) **Amending** to a footpath / **bridleway** / restricted byway / byway open to all traffic the footpath / **bridleway** / restricted byway / byway open to all traffic which runs from:

MURDER COMBE FR 18/18 (POINT X ON ATTACH MAP)

to: WHATLEY FR 18/17 (POINT G ON ATTACHED MAP)

☐ (d) **Varying / adding** to the particulars relating to the footpath / **bridleway** / restricted byway / byway open to all traffic which runs from

to:

3. Documentary Evidence

Please attach copies of those records consulted, labelling clearly on the reverse side what the document is and the appropriate reference. Please also list and sign the section below.

I / We* attach copies of the following documentary evidence (including statements of witnesses) in support of this application:

List of Documents

SEE INDEX ATTACHED
DOCUMENTS FILE SENT TO SEC. - INCLUDE
PHOTOGRAPHS.

Dated 04/06/2014

Signed..

*delete as applicable

4. Photographs of the Application Route

Please take photographs of all parts of the application route including the start and end of the alleged route and include these when submitting your application. Please also write on the back of the photo details of where it was taken.

5. Consultations

You should consult your local Parish Council regarding the proposed route. You should write to them with a copy of a map showing the alleged route clearly, along with a description of what is being proposed and asking for any comments or factual information they may be able to provide, allowing 28 days for a reply. Please attach any response you receive to the application. You may also wish to consult your local County Councillor and District Council in addition.

applicant's responsibility does not stop with the submission of the application. The applicant will be the promoter of the application and will be required to support it at various stages (please see the pre application advice). If the process seems too onerous, the Parish Council or certain user groups may be interested in assisting. The applicant may be requested to carry out further investigation into the evidence, to answer queries, to serve required notices and in the event of objections to the proposal be called as a witness at a public local inquiry. However, should the County Council decide to make an order, the applicant's necessary work to publish and defend it at public inquiry will be undertaken by the Council.

It is important for the applicant to be aware that in investigating Definitive Map modification the County Council, as Surveying Authority, is under a duty to record the true status of the land concerned. The evidence may reveal that the claimed way is a:-

Public Footpath – which may be used by members of the public on foot

Public Bridleway – which may be used by walkers, horse riders and cyclists

Restricted Byway (formally called a Road Used as a Public Path) – which may be used by all the above and horse drawn carts or carriages

Way Open to All Traffic (BOAT) – which may be used by all the above and mechanically propelled vehicles

Following research, the investigating officer may conclude that the way is shown on the records or has no public rights at all.

If you wish to apply for a BOAT please contact this department on the number and details on the back of this form for the latest information and legislation.

Attach a list showing who you have consulted and copies of any replies to your queries to this application form.

Signature of the Applicant(s)

Sign and date the form below.

Name of applicant(s)

[Redacted] [Redacted] THE TRAILS TRUST

04/06/2014

A map with the claimed route marked clearly must be attached to this form.

For applications in South Somerset please contact the Weymouth Office:

Land Registry, Weymouth Office
Melcombe Court
1 Cumberland Drive
Weymouth
Dorset
DT4 9TT

TEL: 01305 363636
FAX: 01305 363646

Or go to the Land Registry website www.landregistry.gov.uk

Should you discover the identities of any landowners or occupiers of the land affected by the application please complete the form overleaf.




PIF Fraser Free

WORKS

PLAN

Murder Combe
whatley / mells

briellway

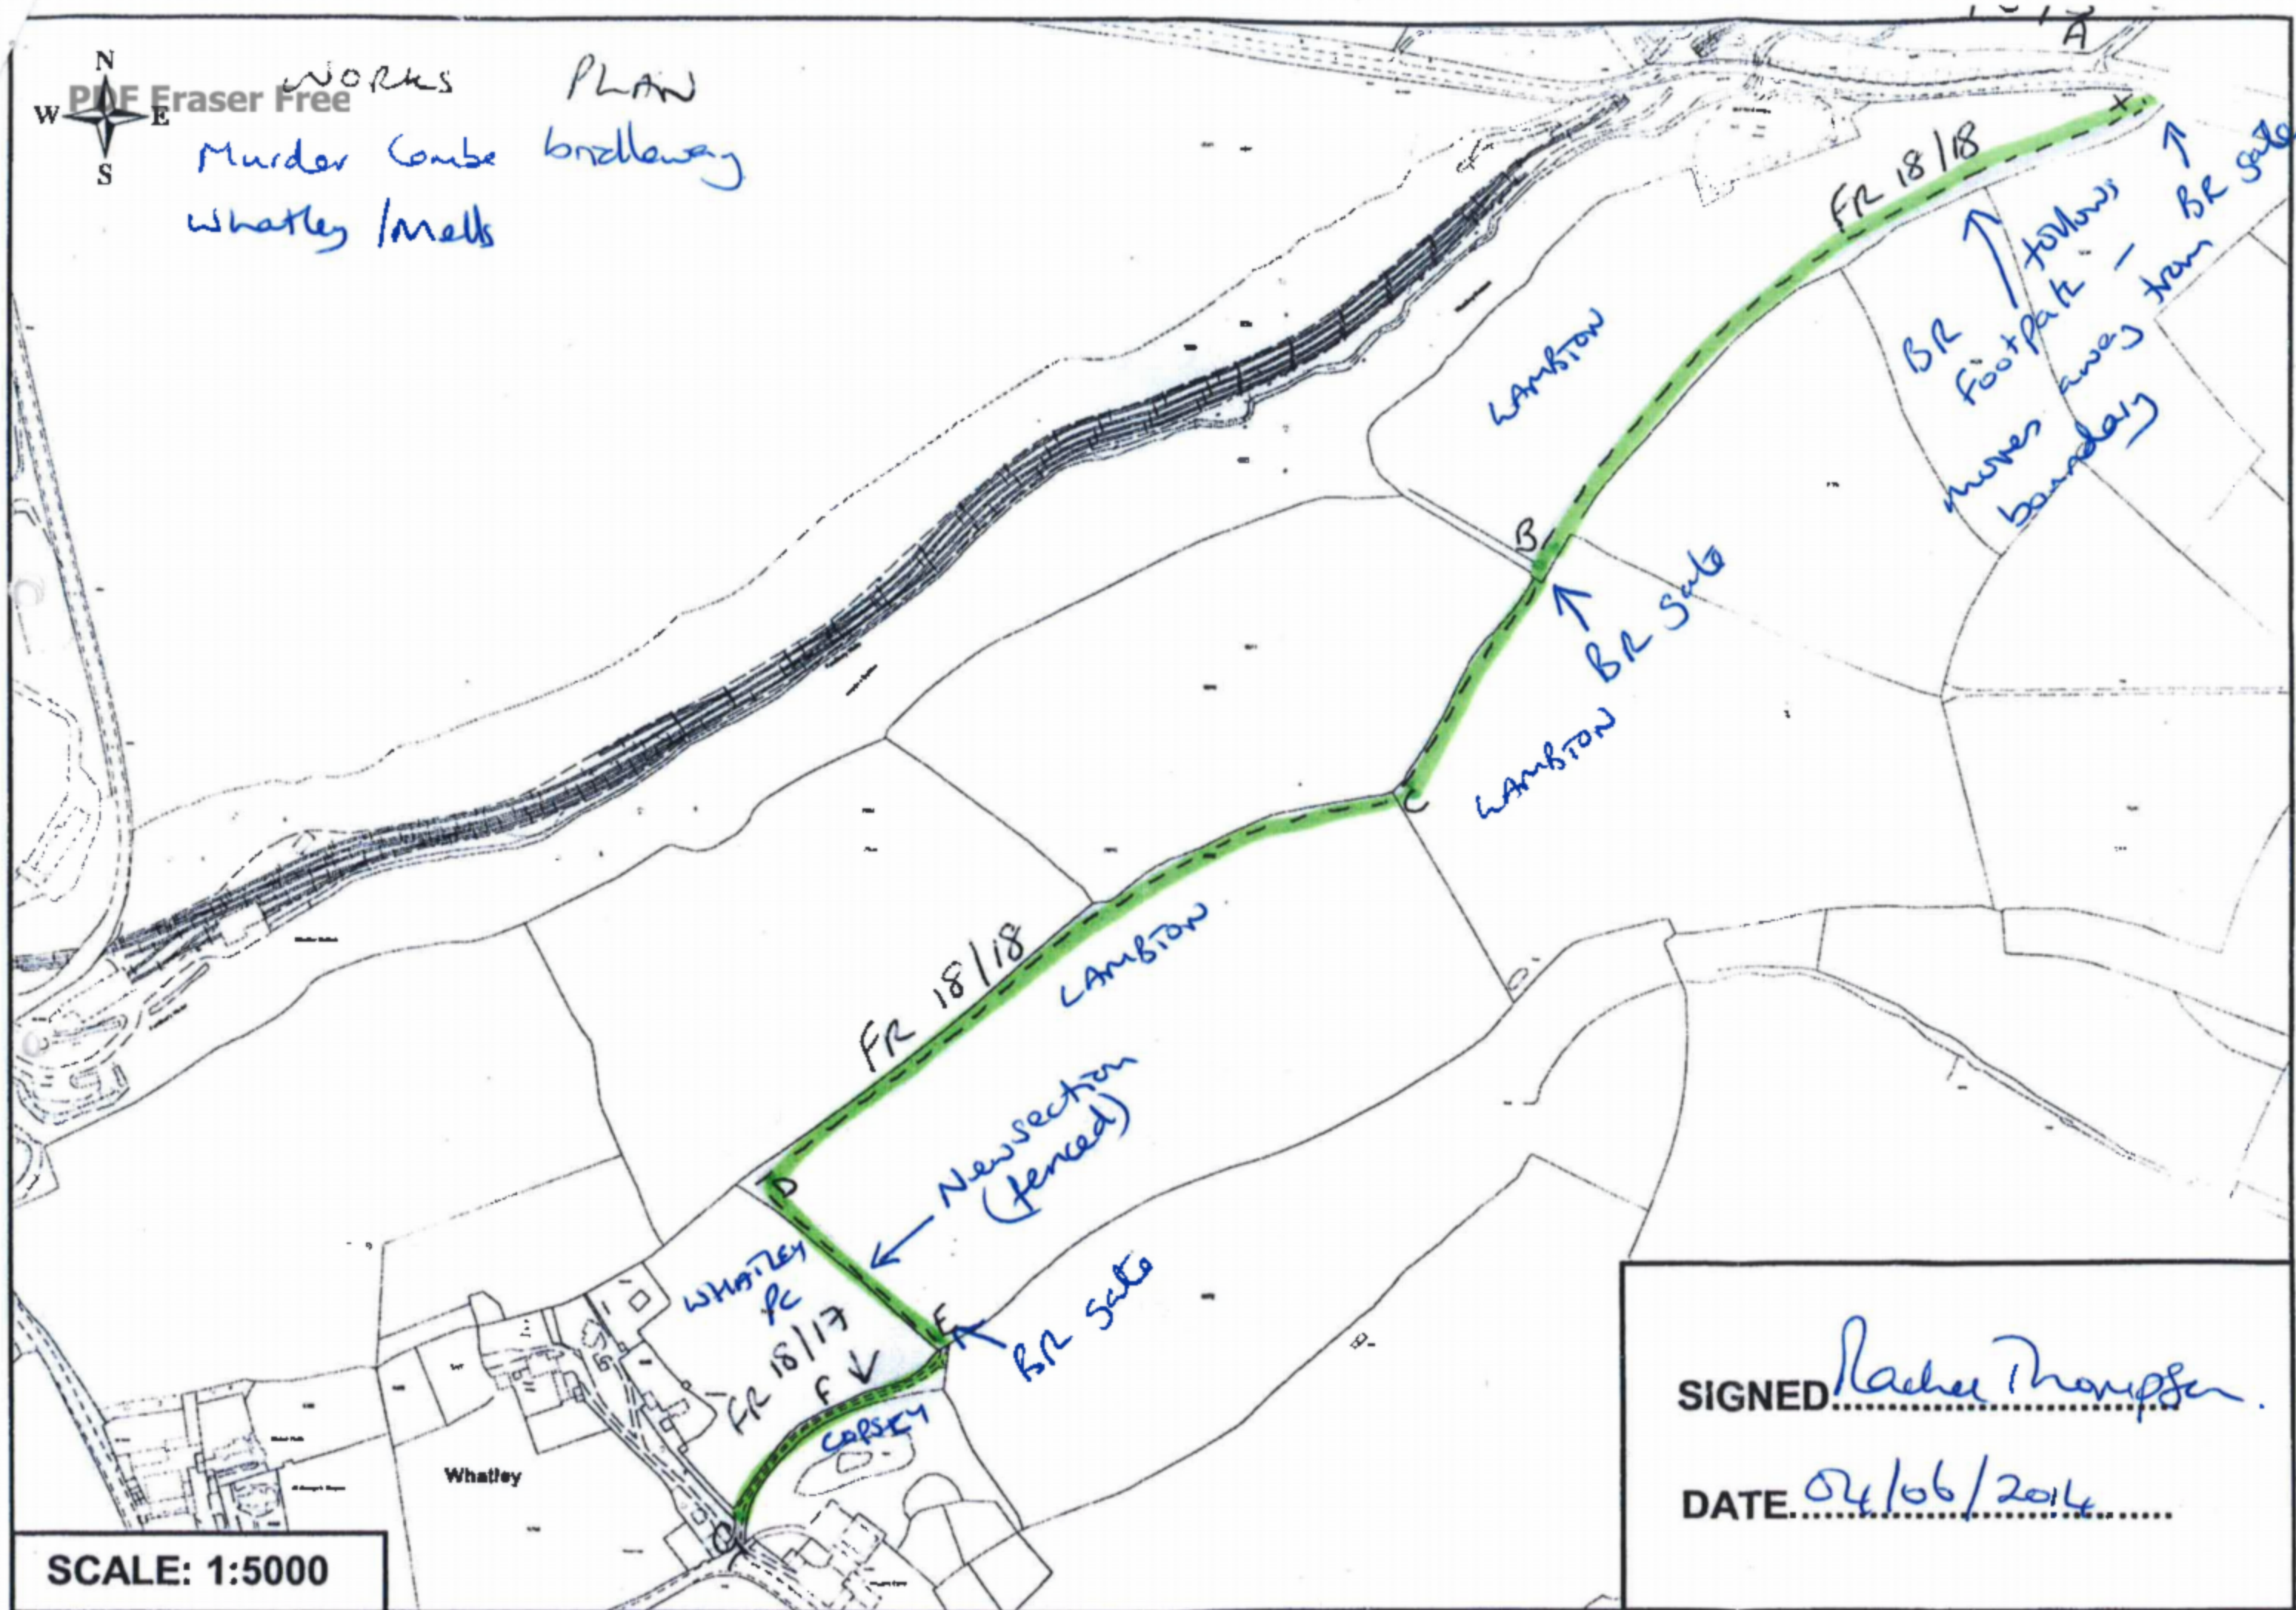

SCALE: 1:5000

SIGNED Rachel Thompson

DATE 04/06/2014